

Name Emile Saulnier
 Address 16 Forest Street
 Lexington, Mass.

Service No. 218

Locatic 16 Forest Street

Kind of Pipe

Size

Size of Main

~~Repair~~ ~~Renewal~~ - New Service

Com. 11-6-50

Location

Date	Material	Amount	Total	Date	Amount
Aug. 24, '50	Labor	1 30	1 30	Aug. 24, '50	1 30
	10% Overhead		13		13
	14' - 3/4" Copper Tubing @ .275	3 85	12 10		3 85
	1 - 3/4" C x 1/2" I.W.H. @ .85	3 29	3 29		3 85
	Trucking 1 hr. @ .75		75		3 85
			17 57		3 85
				Aug. 24, '50	1 30
				14' - 3/4" Copper Tubing @ .275	3 85
				1 - 3/4" C Corp-cock	3 15
				1 - 3/4" C x 3/4" C Curb-cock	3 85
				1 - Box & Rod	3 35
				1 - 1/2" Offset Tail Piece	2
				1 - 3/8" Straight Tail Piece	42
				Trucking 1 hr. @ .75	75
					17 09
	Labor				

Hadley Press, Inc., Lexington

DATE _____

TOWN OF LEXINGTON—BOARD OF PUBLIC WORKS

WATER DIVISION

The undersigned applies for a supply of water at No. _____ St. and hereby agrees to comply with the rules and regulations as now, or at any future time, established by the Board of Selectmen.

Am't. of Estimate \$ _____


Owner _____

Am't. Paid \$ _____

Address _____

Builder _____

Sketch of Service Here

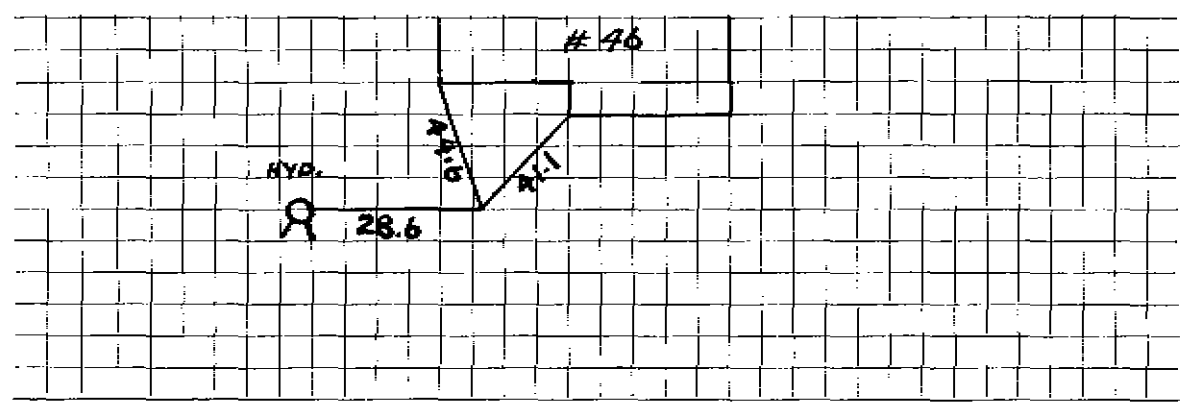

Connection made in _____ Street.

Work completed _____ 19

Remarks: