

Name Ahern & Pichette

1268
Service No. 33 961

Address 48 Forest Street

#48 Forest St

Location ~~2nd house on Forest St. from Mass. Ave.~~

Kind of Pipe

Size

Size of Main

~~Repair~~ ~~Renewal~~ New Service

Location

Date

Material

Amount

Total

Date

Amount

37' 1" C.L. Pipe @.27 9 99

2 1" L.L. Cgup. @.25 50

2 1" L.L. Ells @.25 50

1 S & W 3 00

2 1" Br. Sp. Nip. @ .25 50

Trucking 75

15 24

48 Hrs. Labor @ .55 26 40

4 " " @ .65 2 60

29 00

15% Overhead

4 35

48 59

Labor Time for sewer and water services

Oct. 11 1928 - Cash

48 59

Hadley Press, Inc. Lexington

5/1/28

DATE April 14, 1928

TOWN OF LEXINGTON—BOARD OF PUBLIC WORKS

WATER DIVISION

The undersigned applies for a supply of water at No. Forest St. and hereby agrees to comply with the rules and regulations as now, or at any future time, established by the Board of Selectmen.

Am't. of Estimate \$ _____

Owner


Maurice V. Johnson
Bertha V. Pelette

Am't. Paid \$ _____

Address

Builder _____

Sketch of Service Here

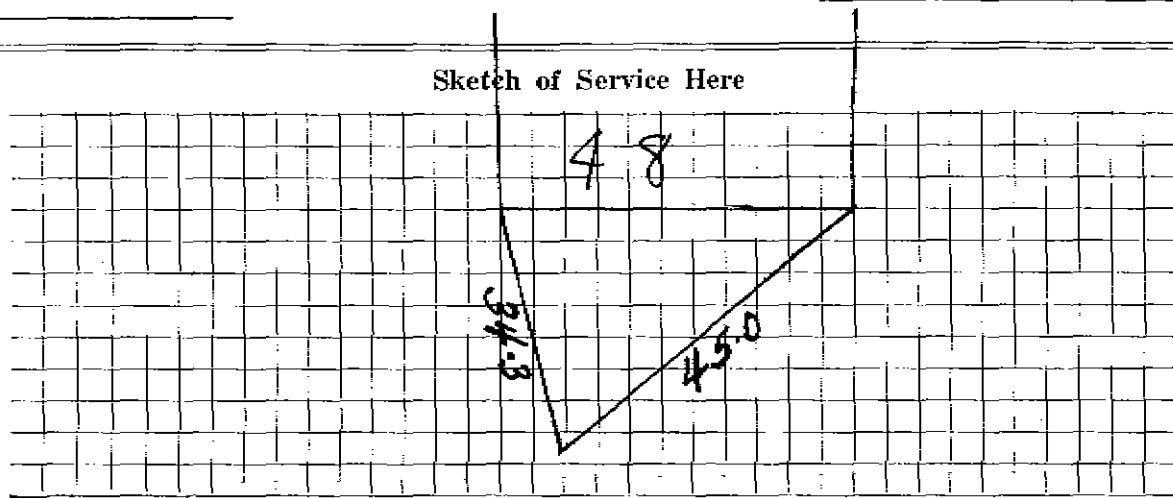

Connection made in _____ Street.

Work completed _____ 19

Remarks: