

WATER SERVICE RECORD

Name Edward McCarthy

Service No. 26

Address 49 Forest Street

Location

~~Repair~~—Renewal—~~New Service~~ W.O. #6538


SEP 25 1978

Date	Material	Amount	Total	Date		Amount
8-21-78	Labor	82.50		2-15-78	Deposit	250.00
	10% C.H.	8.25	90.75	9-25-78	Refund	93.57
	48' 3/4" Copper tubing @.74		35.52			156.43
	1 3/4" Stop & Waste		17.10		OUTSIDE	
	1 3/4" x 5/8 Reducer		1.56	8-21 & 9-1-78	Labor	
	1 Ground Clamp		1.00	12	3/4" Copper tubing	
	1 5/8" Tail piece		1.00	1	3/4" Adapter to L.L. Corp.	
	1 hr. Trucking		3.00	1	3/4" Curb	
	1 hr. Town Shovel		6.50	1	Box & Rod	
			156.43	2	ton Cold Patch	
					Patch Street 9 x 10	
					Patch Sidewalk 10 x 5	
				4 1/2	hrs. Trucking	
				2	hrs. Town Shovel	
				1	hr. Roller	
				1	hr. Loader & Compressor	

DATE _____

TOWN OF LEXINGTON — BOARD OF PUBLIC WORKS
WATER DIVISION

Sketch of Service Here

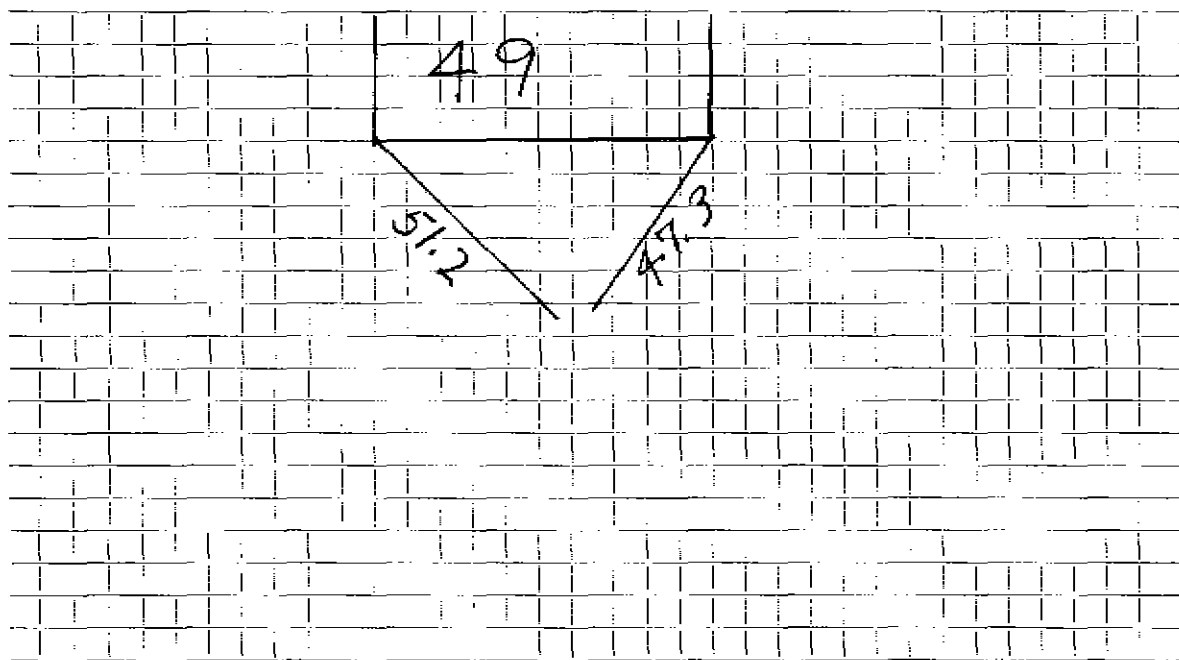

Connection made in Street. Work completed

Remarks:
.....
.....