

Name Allen C. Smith

1241

Service No. ¹¹³ 940

Address 5 Forest St.

Location 5 Forest St.

Kind of Pipe

Size

Size of Main

Repair—Renewal—New Service

Location *Comm. 11-17-58*

Date

Material

Amount

Total

Date

Amount

6/18/58

Labor	50	44
10% overhead	5	04
	55	48
26' 3/4" copper tubing @ .37		9 62
1 3/4" Cx 1/2 IWH stop & waste		5 84
1 1" x 3/4" bushing		59
1 3/4" close nipple		67
1 3/4" 2 part union		1 24
1 hr. trucking @ .75		75

55 48

9 62

5 84

59

67

1 24

75

74 19

~~6-16-58~~

~~11-17-58~~

12-13-43

Deposit

Returned

16' 3/4" Copper
 1 3/4" Comp Cock
 1 3/4" C.XI-Iron Curb Cock

75.00

81

74.19

Labor

DATE _____

TOWN OF LEXINGTON—BOARD OF PUBLIC WORKS

WATER DIVISION

The undersigned applies for a supply of water at No. _____ St. and hereby agrees to comply with the rules and regulations as now, or at any future time, established by the Board of Selectmen.

Am't. of Estimate \$ _____

Owner

A.C. Smith


Am't. Paid \$ _____

Address

5. Forest St.

Builder _____

Sketch of Service Here

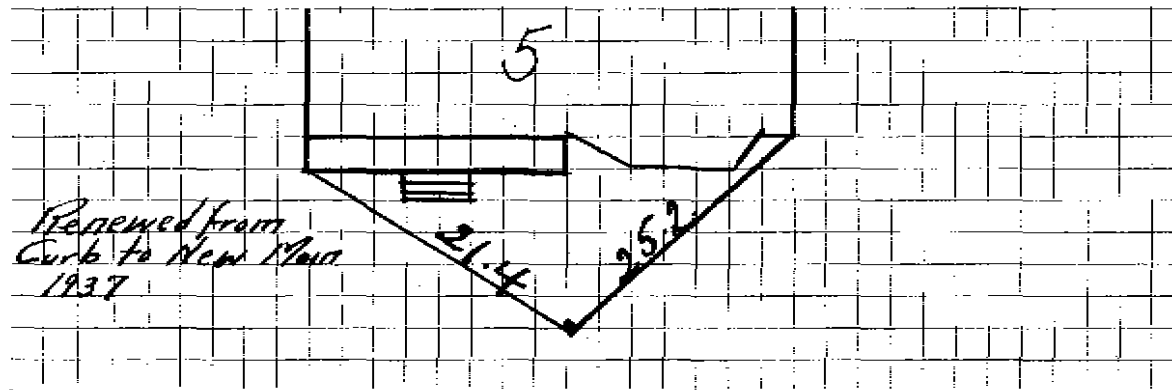

Connection made in _____ Street.

Work completed _____ 19

Remarks: