

Name Ahern & Pichette
 Address 50 Forest Street

Service No. ~~31~~ 963
 # 6293

Location ~~1st House from Mass. Ave.~~ #50 Forest St

Kind of Pipe

Size

Size of Main

~~Repair - Renewal~~ - New Service

Location

Date	Material	Amount	Total	Date	Amount
	36 1" C.L. Pipe @.27	9 72			
	2 1" L.L. Ells @.30	60			
	2 1" L.L. Coupling @.25	50			
	1 S & W	3 00			
	1 1" Br. Sp. Nipple	25			
	Trucking	75	14 82		
5/1/28	42 Hrs. Labor @ .55	23 10		Oct. 11 1928 - Cash	44 38
	4 " " @ .65	2 60	25 70		
	15% Overhead		3 86		
	Labor		44 38		
				1/12/98	REPAIR AT CURB
				1'	3/4 COPPER
				1-	1" X 3/4 M-APT
				1	1" Iron Comp. X 3/4 C
				1-12-98	IRON SERVICE IN ST
				7-9-98	REMOVED
					21'-3/4 Copper
					1-3/4 Corp. Adapt.
					1-3/4 Curb STOP

DATE April 14, 1928.

TOWN OF LEXINGTON—BOARD OF PUBLIC WORKS

WATER DIVISION

The undersigned applies for a supply of water at No. Forest St. and hereby agrees to comply with the rules and regulations as now, or at any future time, established by the Board of Selectmen.

Am't. of Estimate \$ _____

Owner

Maurice P. Ghera
Bertha V. Picotello


Am't. Paid \$ _____

Address

178 Mass Ave
Lexington

Builder _____

Sketch of Service Here

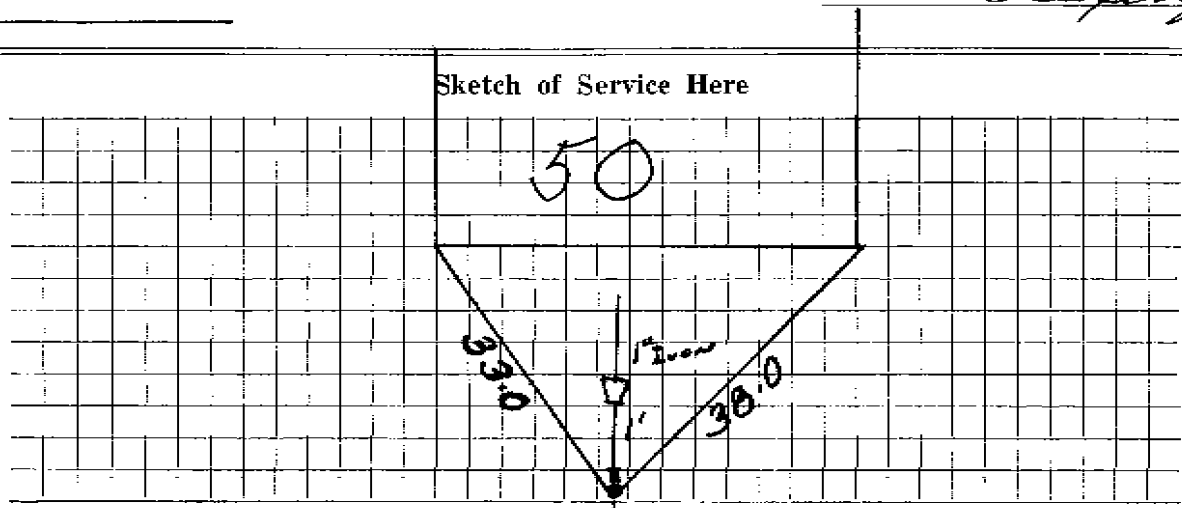

Connection made in _____

Street. 1" IRON Cop. 3/4

Work completed _____ 19

Remarks: