

WATER SERVICE RECORD

Name John Manley

Service No. 6

Address 53 Forest Street

Location

~~Repair~~—Renewal—~~New Service~~ W.O. #3156

*Comm 7-28-75*


Date	Material	Amount	Total	Date	Amount	
3-17-75	Labor	40.14		3-17-75	Deposit	150.00
	10% O.H.	4.01	\$44.15	7-21-75	Retard	49.49
28'	3/4" Copper Pipe	@1.01	28.28			100.53
1	3/4" Wheel Valve		15.43		NON-CHARGE (outside)	
1	3/4" Brass Elbow		1.74	3-17-75	Labor	\$80.28
2	3/4" x 1" Nipples Brass		2.80	3-26-75	"	21.85
1	3/4" Brass Coupling		1.63		6' 3/4" Copper Pipe	\$102.13
1	Hr. Backhoe		6.50		1 3/4" Curb Cock	
			\$100.53		1 3/4" Adapter	
					1 1/2 Ton Cold Patch	
					1 1/2 Hrs. Trucking	
					1 Hr. Backhoe	
					1 Hr. Pickup	
					1 Hr. Compressor	
					1 Hr. Loader	
					1 Patch 15' x 6'	

DATE \_\_\_\_\_

TOWN OF LEXINGTON — BOARD OF PUBLIC WORKS

**WATER DIVISION**

Sketch of Service Here

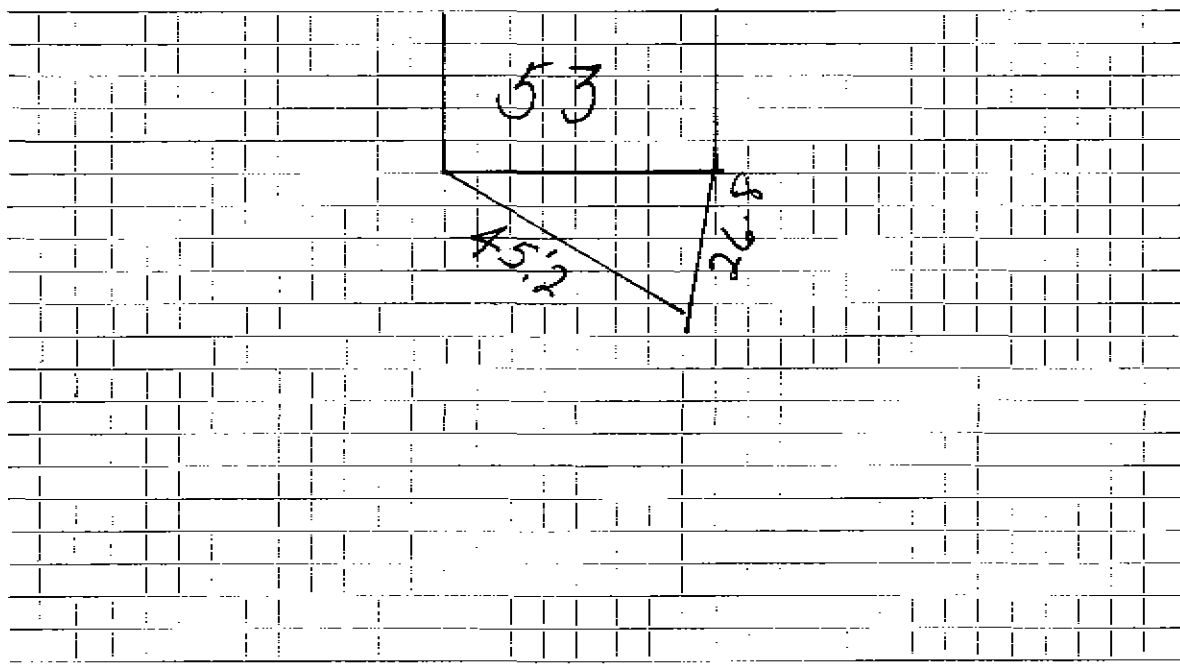

Connection made in ..... Street.      Work completed .....

Remarks: .....  
.....  
.....