

WATER SERVICE RECORD

Name

Donal

Service No.

Address

54 Forest Street

860-1385

Location

~~Repair~~ ~~Renewal~~ New Service


Date	Material	Amount	Total	Date	Amount
7/10/28	37' 1" CLP				
					NON CHARGE
				4-7-59	Labor 32.86
					24' 3/4" Copper tube @ .3666 8.80
					1 3/4" Adapter 1.95
					1 1" Style 38 Clamp 2.14
					1 1" x 5" C.L. Nipple .34
					1 3/4" Curb Cock 4.64
					1 1" Lead Lined Coupling 1.00
					2 hrs. Pippin Backhoe @ 4.50 9.00
					2 hrs. Trucking @ .75 1.50
					<u>62.23</u>

DATE \_\_\_\_\_

TOWN OF LEXINGTON — BOARD OF PUBLIC WORKS

WATER DIVISION

Sketch of Service Here

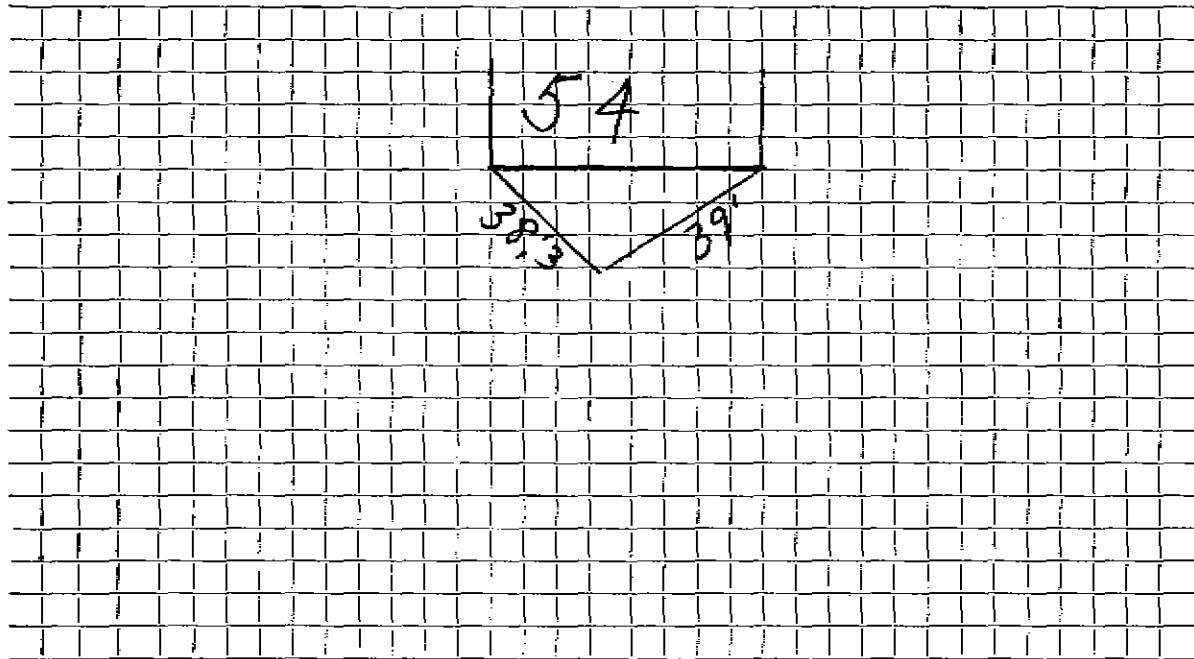

Connection made in \_\_\_\_\_ Street. Work completed \_\_\_\_\_

Remarks: \_\_\_\_\_  
\_\_\_\_\_  
\_\_\_\_\_