

Name Check From: Hazel W. Barry

Owner: John A., Lappen

Service No. ~~#~~ 969 ²⁹

Address 16 Vaille Ave.,
57 Forest St.

Location 57 Forest Street

Kind of Pipe

Size

Size of Main

Repair—Renewal—New Service

Location

Date
1941

Material

Amount

Total

Date

Amount

June 4,

3 hrs. @ 60¢

1 80

10% Overhead

18

1 98

50' 3/4" Copper tubing @ 19¢

9 50

1 3/4" x 1/2" I.S. & W.

2 50

2 hrs. trucking @ 75¢

1 50

15 48

May 20, 1941 Deposited

15 00

CHARGE: \$15.00

Labor

DATE 5/20/41

TOWN OF LEXINGTON—BOARD OF PUBLIC WORKS
WATER DIVISION

The undersigned applies for a supply of water at No. 57 Forest St. and hereby agrees to comply with the rules and regulations as now, or at any future time, established by the Board of Selectmen.

Am't. of Estimate \$ _____


Owner James A. Lapper

Am't. Paid \$ _____

Address 38 Percy Rd.
Lexington

Builder Clarence W. Barry

Sketch of Service Here

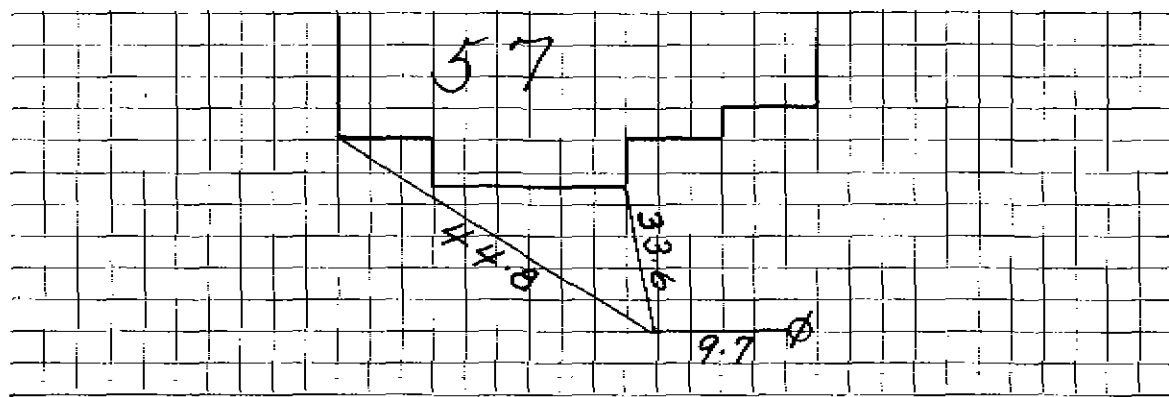

Connection made in _____ Street. Work completed _____ 19

Remarks: