

WATER SERVICE RECORD

2924

Name Robert A. Nelson

Service No. 203

Address 58 Forest Street

Location

~~RENEWAL - NEW SERVICE~~

Comm 11-16-57


Date	Material	Amount	Total	Date	Amount
9-3-59	Labor	41.73		9-1-59	160.00
	10% O.E.	<u>4.17</u>	45.90	11-16-57	<u>96.85</u>
32'	3/4" Copper tubing@.41		13.12		73.75
1	3/4" Cx 1/2 I.W.F. Stop&Waste		5.98		
3	Hrs. Trucking@.75		2.25		NON CHARGE
1	Hr. Town Shovel@6.50		<u>6.50</u>		Labor 15.42
			73.75	18'	3/4" Copper tubing@.41 7.38
				1	3/4" C Curb Cock 5.98
				1	3/4" Corp Adapter 4.87
				1	Box & Rod 5.00
				1	1/2 Straight tailpiece .50
				1	1/2 Offset tailpiece .50
					16 x 3 Patch <u>16.00</u>
					55.45

DATE _____

TOWN OF LEXINGTON — BOARD OF PUBLIC WORKS

WATER DIVISION

Sketch of Service Here

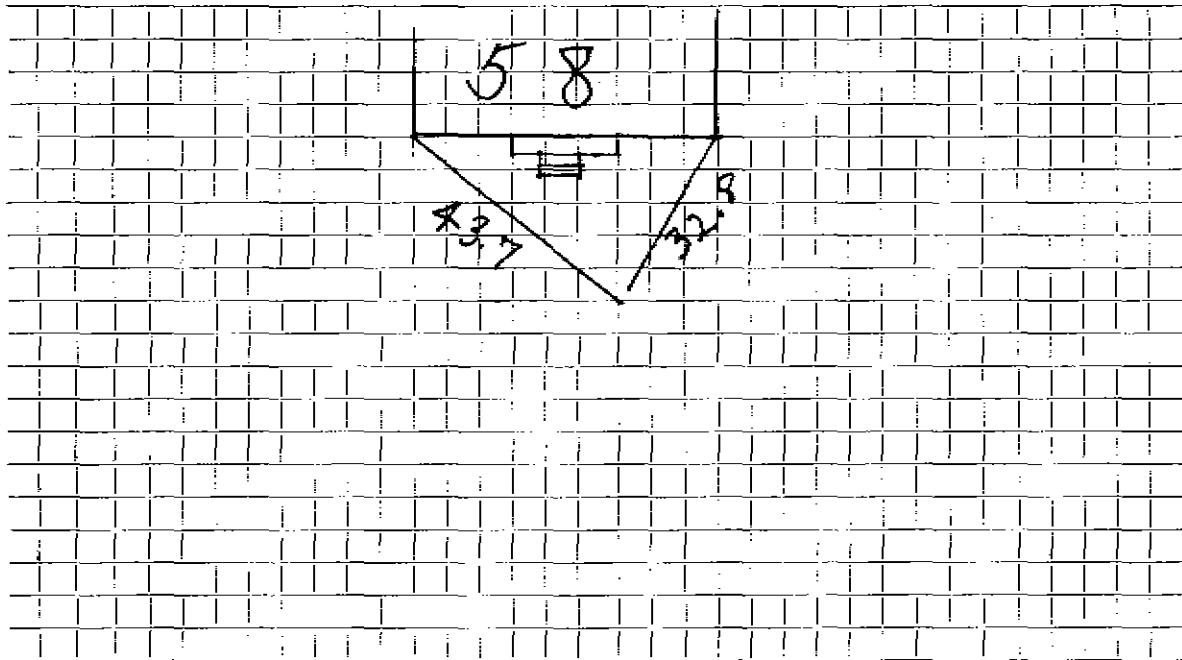

Connection made in Street. Work completed

Remarks:

.....

.....