

Name Marjorie Pierce

Service No. 58 971

Address 59 Forest St., Lexington

3488

Location Same

Kind of Pipe

Size

Size of Main

~~Repair~~ ~~Renewal~~ New Service

Location

Date	Material	Amount	Total	Date	Amount
1935					
Dec. 3	3 hrs. labor @ 60¢	1 80		Dec 17 1935	22 00
<i>1-28-36</i>	42 3/4" C. Pipe @ 17¢	7 14		Jan. 18, 1936	7 06
<i>Cont. 12/34</i>	1 Stop & Waste	2 00			
<i>Russell</i>	Trucking	2 00			12 74
			12 94		
	Labor				

Hadley Luce, Inc., Lexington

DATE November 30, 1935

# TOWN OF LEXINGTON - BOARD OF PUBLIC WORKS

## WATER DIVISION

The undersigned applies for a supply of water at No. 59 Forest St St. and hereby agrees to comply with the rules and regulations as now, or at any future time, established by the Board of Selectmen.

Am't. of Estimate \$ 22<sup>00</sup>

Owner


Marjorie Pierce  
B. T. H.

Am't. Paid \$ \_\_\_\_\_

Address

Builder \_\_\_\_\_

Sketch of Service Here

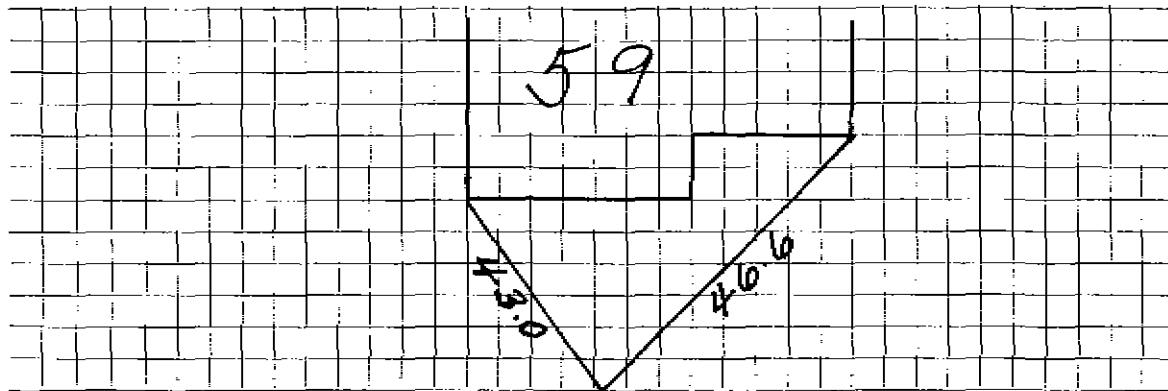

Connection made in \_\_\_\_\_ Street.

Work completed \_\_\_\_\_ 19

Remarks: