

WATER SERVICE RECORD

#5619
#5934
Service No. 202

Name Irving B. Pierce

Address 60 Forest Street

Location

~~Repair—Renewal—NEW SERVICE~~


Comm. 11-16-59

Date	Material	Amount	Total	Date		Amount
9-2-59	Labor	38.13		9-1-59	Deposit	100.00
9-3-59	10% O.F.	3.81	41.94	11-16-59	Retained	30.55
	33' 3/4" Copper tubing@.41		13.53			69.45
	1 3/4" Cx 1/2 I.W.H. Stop&Waste		5.98			
	1 Hr. Town Shovel@6.50		6.50		NON CHARGE	
	2 Hrs. Trucking@.75		1.50		Labor	11.54
			69.45		20' 3/4" Copper tubing@.41	8.20
					1 3/4" C Curb Cock	5.98
					1 Box & Rod	5.00
					1 1/2" Straight tailpiece	.50
					1 1/2" Offset tailpiece	.50
						31.72

DATE _____

TOWN OF LEXINGTON — BOARD OF PUBLIC WORKS
WATER DIVISION

Sketch of Service Here

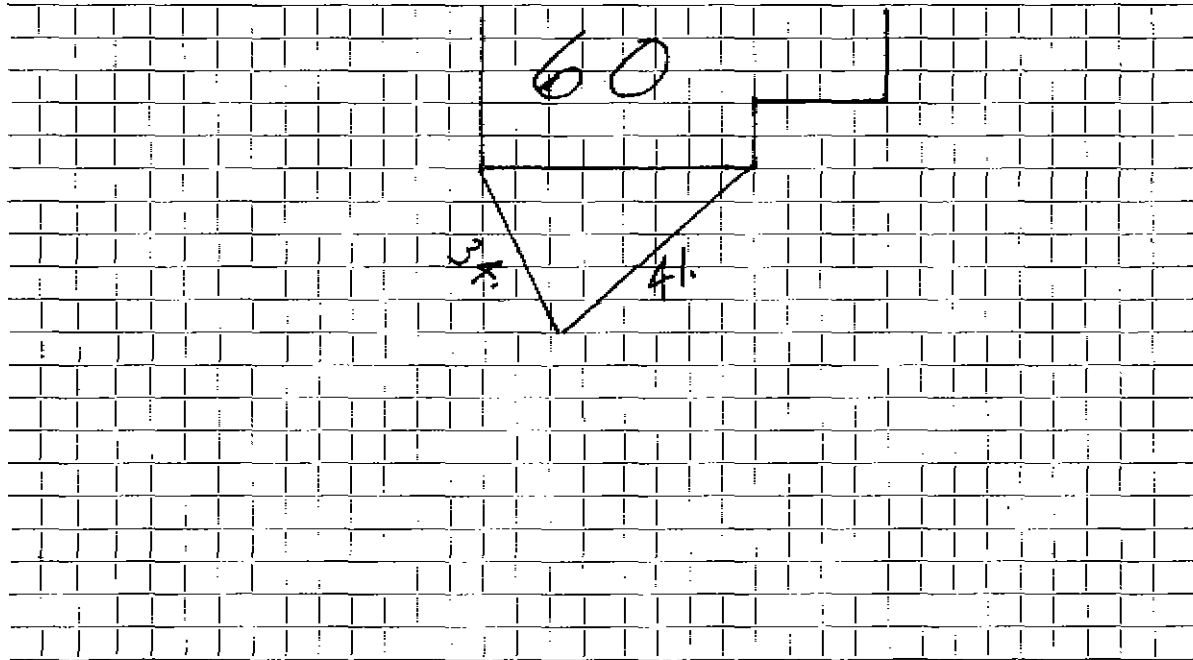

Connection made in Street. Work completed

Remarks:

.....

.....