

WATER SERVICE RECORD

Name A. G. Little, Jr.

Service No. 184

Address 7 Forest Street

Location

Repair - Renewal - ~~NEW SERVICE~~

*Com 9-13-54*


Date	Material	Amount	Total	Date	Amount
8/4/54	Labor	13 30		8-4-54	Deposited 40 00
	10% overhead	1 33	14 63	9-13-54	Refunded 6 12
	20' - 3/4" copper tubing @ .35		7 00		NON CHARGE 33 68
	1 - 3/4" C x 1 1/2" I.W.F. stop & waste		4 00		
	1 hr. Littlefield shovel		7 50		
	1 hr. trucking		75		
			33 88		
				1937	Renewed Curb To NEW MAIN

DATE \_\_\_\_\_

TOWN OF LEXINGTON — BOARD OF PUBLIC WORKS

**WATER DIVISION**

Sketch of Service Here

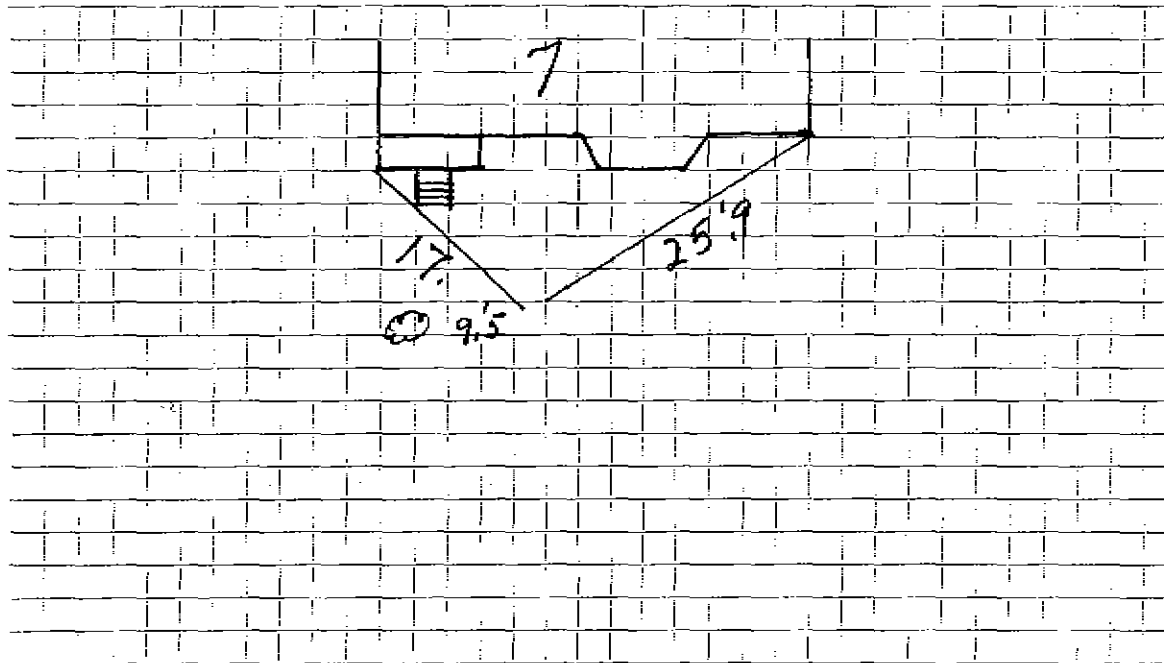

Connection made in ..... Street: Work completed .....

Remarks: .....

.....

.....