




DATE \_\_\_\_\_

TOWN OF LEXINGTON — BOARD OF PUBLIC WORKS

**WATER DIVISION**

Sketch of Service Here

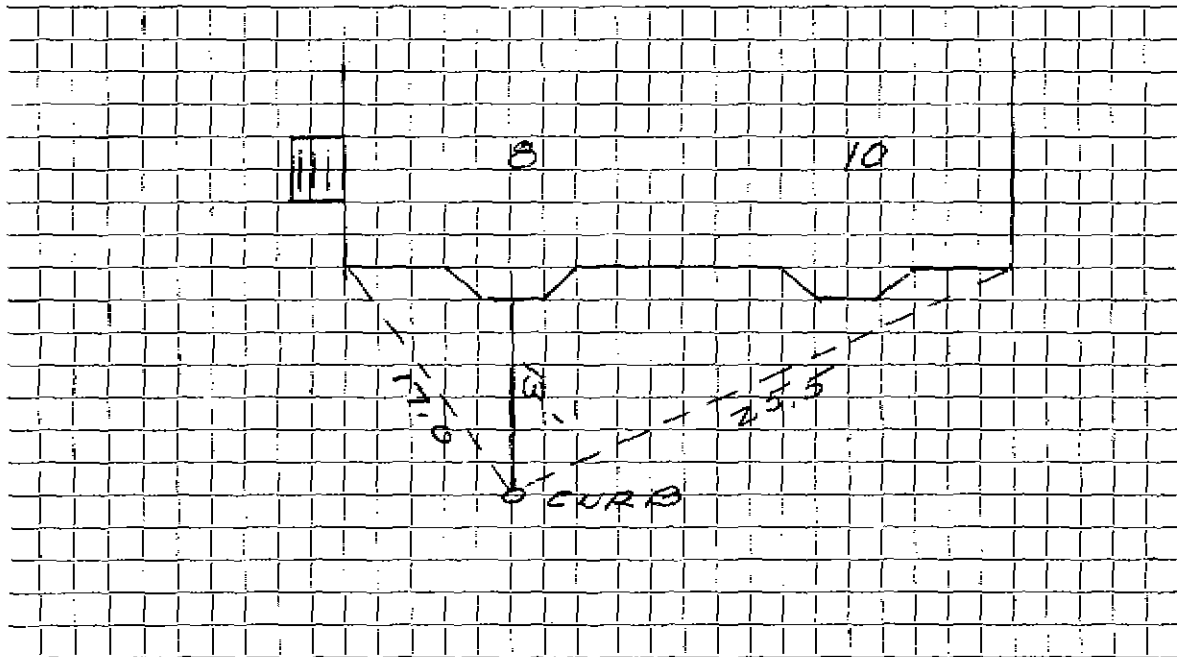

Connection made in FOREST Street. Work completed .....

Remarks: CONNECT TO EXIST. CURB .....

.....  
.....