

WATER SERVICE RECORD

Name James Ofria

Service No. 180

Address #10¹⁰ Lot 217 Foster Road

Location

~~Repair/~~Renewal - New Service

Jan 12-31-58

Date	Material	Amount	Total	Date	Amount
9-8-58	Labor	3.38		8-29-58	35 00
	10% O.H.	.34	3.72	12-31-58	8 84
	34' 3/4" Copper tubing @.37		12.68		25 16
	1 3/4" C x 1/2 I.W.F. Stop & Waste	5.84			<u>NON CHARGE</u>
	1 hr. Trucking @.75	.75		5/5/57	Labor 4 29
	1 3/4" C 3 Part Union	2.27			36' 3/4" Copper tubing 15 22
		25.16			1 3/4" C Corp Cock 4 64
					1 3/4" C Curb Cock 5 94
					1 Box & Rod 4 62
					<u>19 49</u>
					1 1/2 Straight Tailpiece 50
					1 1/2 Offset tailpiece .50
					<u>20.49</u>


DATE _____

TOWN OF LEXINGTON — BOARD OF PUBLIC WORKS

WATER DIVISION

Sketch of Service Here

15

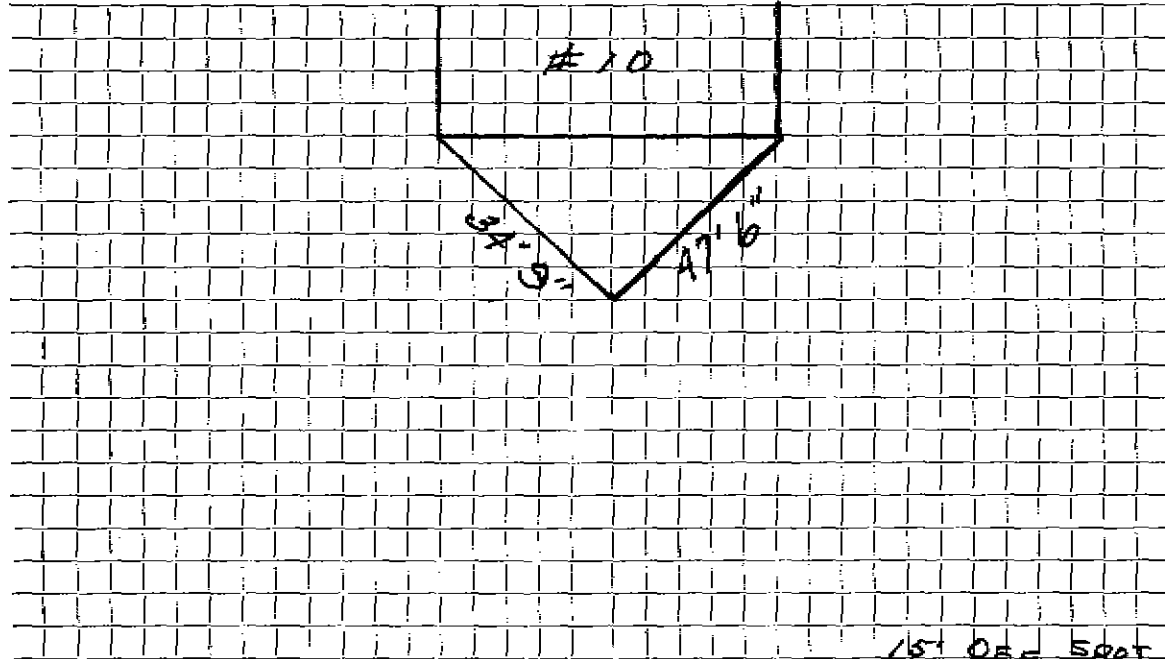

15' off spot

Connection made in Street. Work completed

Remarks:
.....
.....