

**WATER SERVICE RECORD**

Name R. D. Hamilton Const. Co.

Service No. 97

Address 14 Fottler Avenue

Location Lot 64-65

~~REWORK~~ New Service W.O. #9136 Kirkland & Shaw Permit #80

DEC 28 1964

| Date    | CURB TO MAIN<br>Material | Amount | Total | Date     | Amount |
|---------|--------------------------|--------|-------|----------|--------|
| 9-14-64 | Labor                    | 4 73   |       | 8-26-64  | 25 00  |
|         | 10% O.H.                 | 47     | 5 20  | 12-28-64 | 13 87  |
| 30'     | 3/4" Copper Tubing @.42  |        | 12 60 |          | 38 87  |
| 1       | 3/4" Corp Cock           |        | 7 41  |          |        |
| 1       | 3/4" Curb Cock           |        | 8 76  |          |        |
| 1       | Box & Rod                |        | 4 90  |          |        |
|         |                          |        | 38 87 |          |        |
| 9-14-64 | 34' 3/4" Copper Tubing   |        |       |          |        |


*Deposit*  
*Paid by SHC #137*

DATE \_\_\_\_\_

TOWN OF LEXINGTON — BOARD OF PUBLIC WORKS

**WATER DIVISION**

Sketch of Service Here

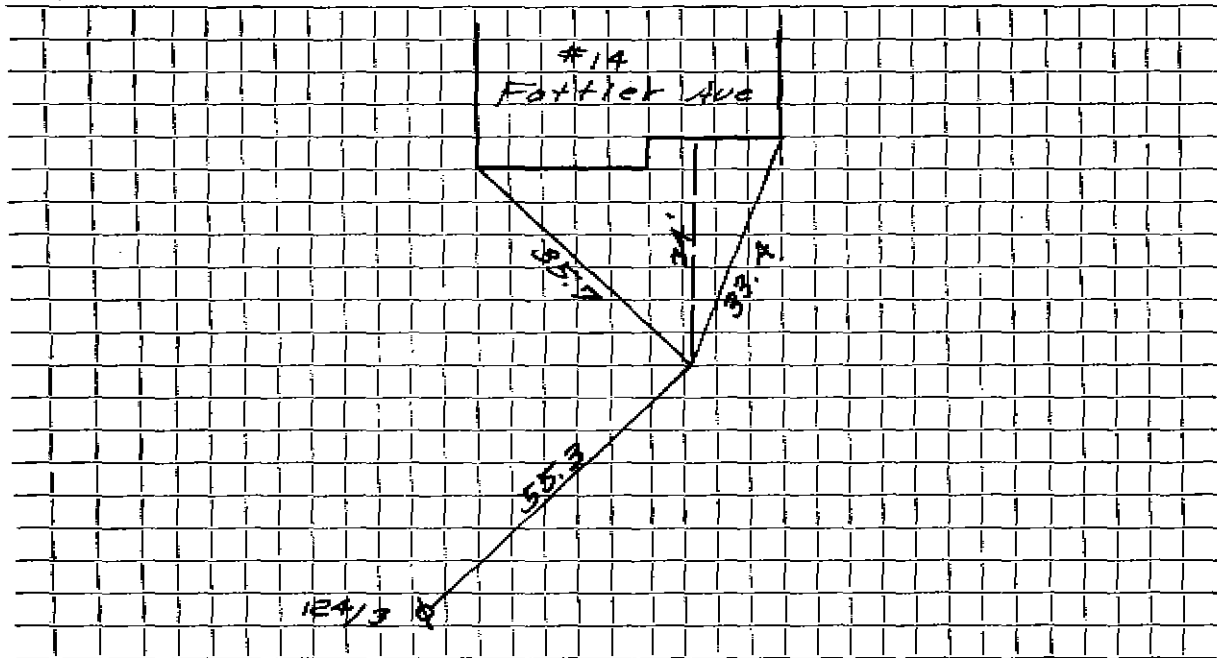

Connection made in ..... Street. Work completed .....

Remarks: .....  
.....  
.....