

WATER SERVICE RECORD

1222

Name 76 Walter Gougian

Service No. 220

Address Lot 219 Foster Road

Location 16 Foster

~~Repair-Renewal~~ New Service

Comm. 12-9-57


Date	Material	Amount	Total	Date	Amount
10/3/57	labor	1 76		9-30-57 Deposit	\$ 35 00
	10% overhead	18		12-2-57 Refund	8 60
			1 94		\$ 26 40
	50' 3/4" copper tubing @.375	18 75			<u>NON CHARGE</u>
	1 3/4" Cx 1/2 IWH stop & waste	4 96		5/5/57 Labor	4 29
	1 hr. trucking @.75	75		22' 3/4" Copper tubing @.4228	9 30
			26 40	1 3/4" C Corp Cock	4 64
				1 3/4" C Curb Cock	5 94
				1 Box & Rod	4 62
					28 79
				1 1/2 straight tail pc	50
				1 1/2 offset	50
					29 79

DATE _____

TOWN OF LEXINGTON — BOARD OF PUBLIC WORKS
WATER DIVISION

Sketch of Service Here

15

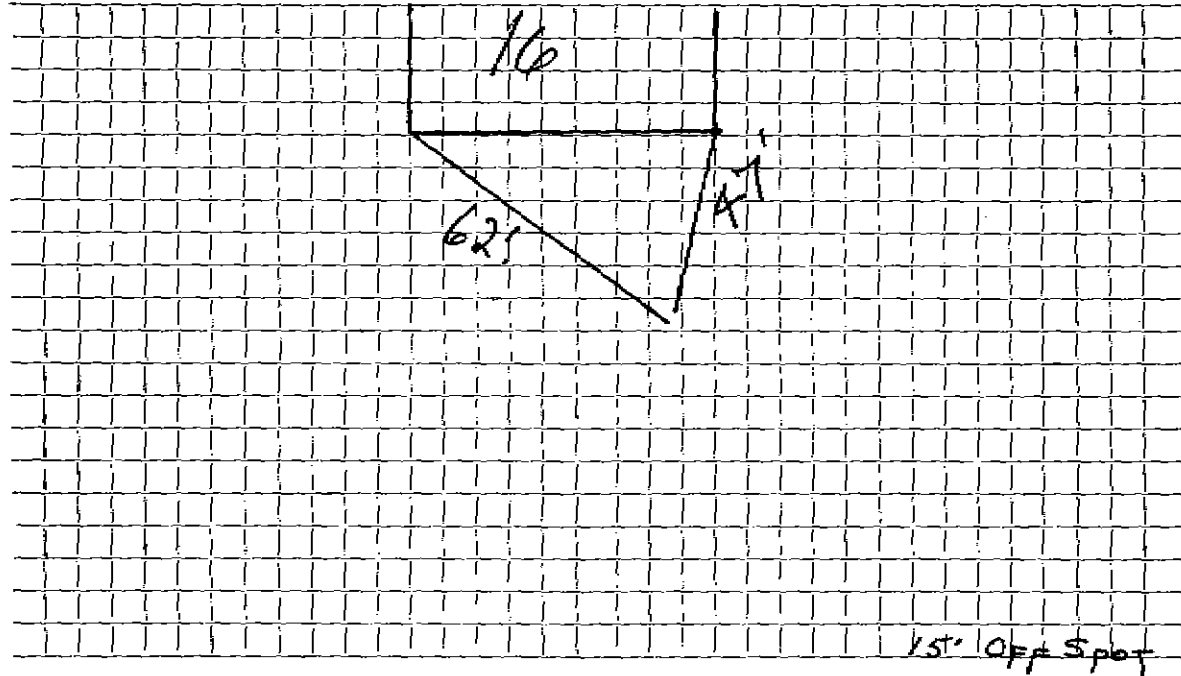

Connection made in Street. Work completed

Remarks:
.....
.....