

WATER SERVICE RECORD

Name Roger T. Wescott

Service No. 264

Address 3 Foster Road

Location

LOT = 192

~~Repair~~ ~~Renewal~~ - New Service


AM. 10-5-53

Date	Material	Amount	Total	Date	Amount
9/11/53	Labor	3 25		7-1-53 Deposited	100 00
	10% Overhead	33	3 58	10-3-53 Refund	61 43
	42' - 3/4" Copper tubing@.3629	15 24	15 24	NON CHARGE	
	1 - 3/4C x 1/2 I.W.H.stop&waste	4 00	4 00	9/11/53 Labor	3 25
	2 hrs. Littlefield shovel @7.50	15 00	15 00	26' - 3/4" Copper tubing@.3629	9 44
	1 hr. trucking		75	1 - 3/4" C. Corp-cock	4 33
			38 57	1 - 3/4" C x 3/4" C. curb-cock	4 67
				1 box and rod	3 90
				1-1/2 straight tail piece	50
				1-1/2 offset tail piece	50
				1 hr. Littlefield shovel	7 50
				1 hr. trucking	75
					34 84

TOWN OF LEXINGTON — BOARD OF PUBLIC WORKS

WATER DIVISION

Sketch of Service Here

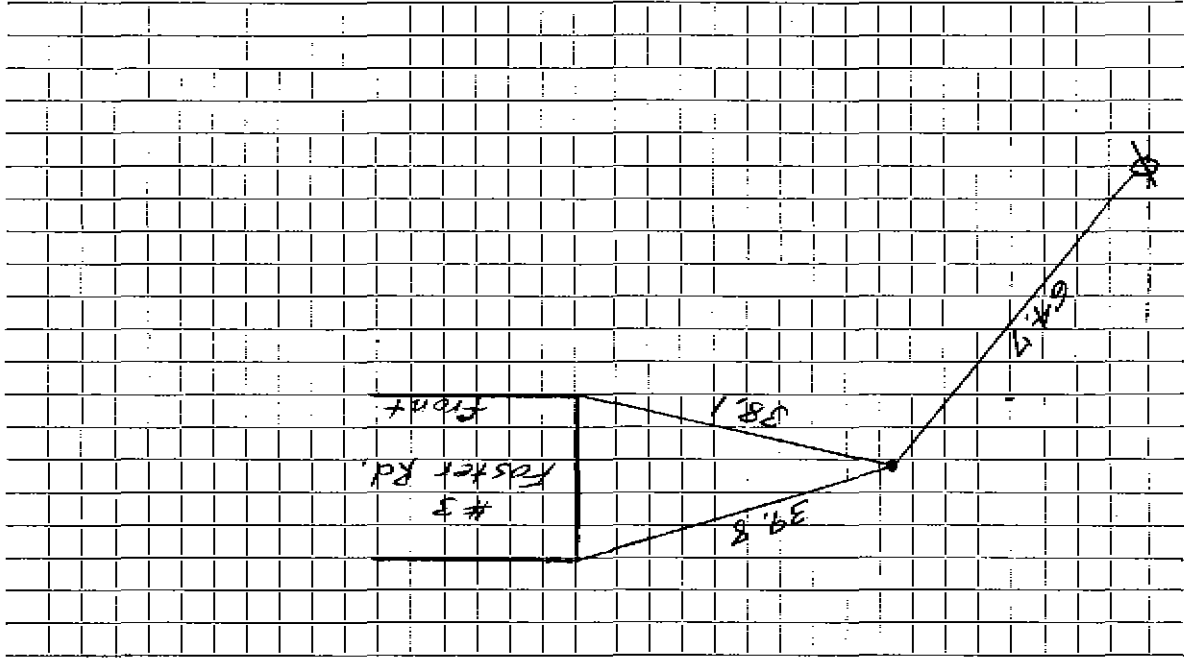

$\frac{1}{329}$

Connection made in

Street.

Work completed

Remarks: