

#5422

WATER SERVICE RECORD

Name Anthony Agresti

Service No. 268

Address 4 Foster Road

#6889

Location

Repair/Replacement - New Service

am. 10-5-53


Date	Material	Amount	Total	Date	Amount
9/14/53	Labor	4 75		7-5-53 Deposited	40 00
	10% Overhead	48	5 23	10-5-53 Reversed	14
	41' - 3/4" Copper tubing @ .3629	14 88			39 86
	1 - 3/4" C x 1/2" I.W.H. stop & waste	4 00		9/14/53 Labor	4 75
	2 hrs. Littlefield shovel	7.50	15 00	9' - 3/4" Copper tubing @ .3629	3 27
	1 hr. trucking		75	1 - 3/4" C. curb-cock	4 35
			39 86	1 - 3/4" C x 3/4" C. curb-cock	4 67
				1 box and rod	3 90
				1 - 3/8" offset tail piece	50
				1 - 1/2" straight tail piece	50
				1 hr. trucking	75
					22 67

DATE _____

TOWN OF LEXINGTON — BOARD OF PUBLIC WORKS

WATER DIVISION

Sketch of Service Here

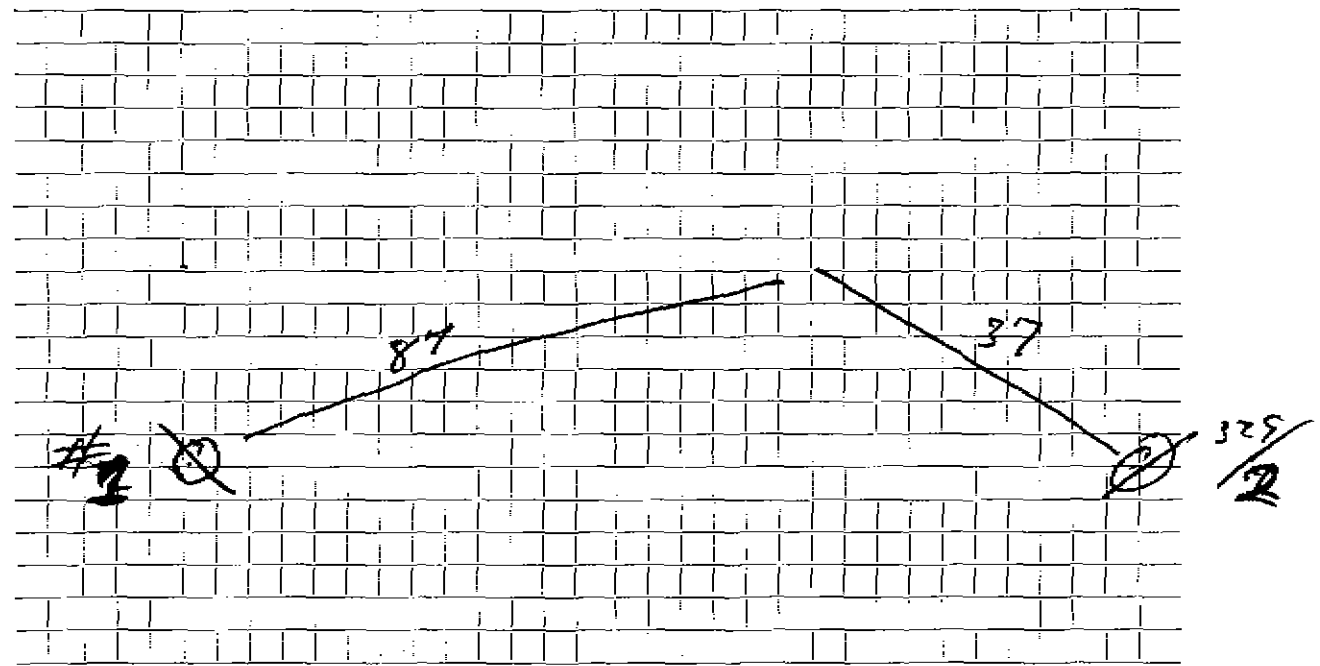

Connection made in Street. Work completed

Remarks:
.....
.....