

WATER SERVICE RECORD

#5597

Name Gerald P. Friel

Service No. 201

Address 6 Foster Road

Location

Repair ~~REPAIR~~ NEW SERVICE


Com. F- 3/53

Date	Material	Amount	Total	Date	Amount
7/30/53	Labor	1 75		7-21-53	25 -
	10% overhead	18	1 93	8-31-53	4 17
	39' - 3/4" Copper tubing@.3629		14 15		<u>NON CHARGE</u>
	1 - 3/4" C. x 1/2" I.W.H. stop & waste	4 00		7/30/53	Labor
	1 hr. trucking		75		17' - 3/4" copper tubing@.3629
			20 83		1 - 3/4" C corp-cock
	TRENCH DUG BY OWNER:				1 - 3/4" C x 3/4" C curb-cock
	J Redmond				1 box and rod
8-8-00	22' 1" COPPER				1 - 1/2" straight tail pc.
	3/4 x 1" MOP T.				1 - 1/2" offset tail pc.
	1 box / 10 bak				1 hr. trucking
					<u>75</u>
					23 82

DATE _____

TOWN OF LEXINGTON — BOARD OF PUBLIC WORKS

WATER DIVISION

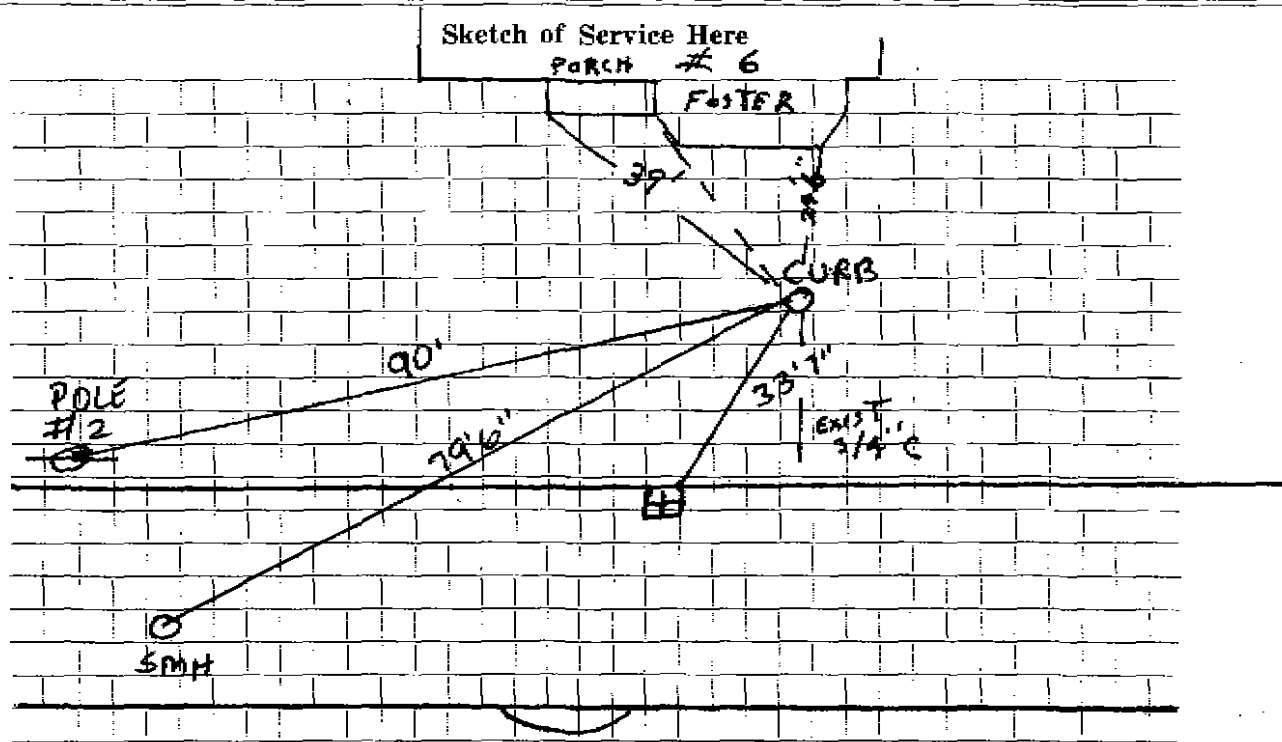

Connection made in Street. Work completed

Remarks: Tear down old house 7-13-00 a