

WATER SERVICE RECORD

1194

Service No. 82

Name Colonial Contractors & Bldrs. Inc.

Address Lot ~~100~~ Foster Road

# 3444

# 7380

Location

Report ~~Renewal~~ New Service

Comp. No. - 11-24-55

Date	Material	Amount	Total	Date	Material	Amount
5/26/58	Labor	3 70		5-12-58	Deposit	35 00
	10% overhead	37	4 07	11-24-58	Retuned	12 50
	32' - 3/4" Copper tubing @ .37		11 84			22 50
	1 - 3/4" Cx 1/2 I.W.H. Stop & Waste		5 84		NON CHARGE	
	1 hr. Trucking		75	5/5/57	Labor	4 29
			22 50		22' 3/4" Copper tubing @ .4228	13 53
					1 3/4" C Corp Cock	4 64
					1 3/4" C Curb Cock	5 94
					1 Box & Rod	4 62
						33 02
					1 - 2 1/2" Straight tailpiece	50
					1 - 2 1/2" Offset tailpiece	50
						34 02


DATE \_\_\_\_\_

TOWN OF LEXINGTON — BOARD OF PUBLIC WORKS

WATER DIVISION

Sketch of Service Here

15

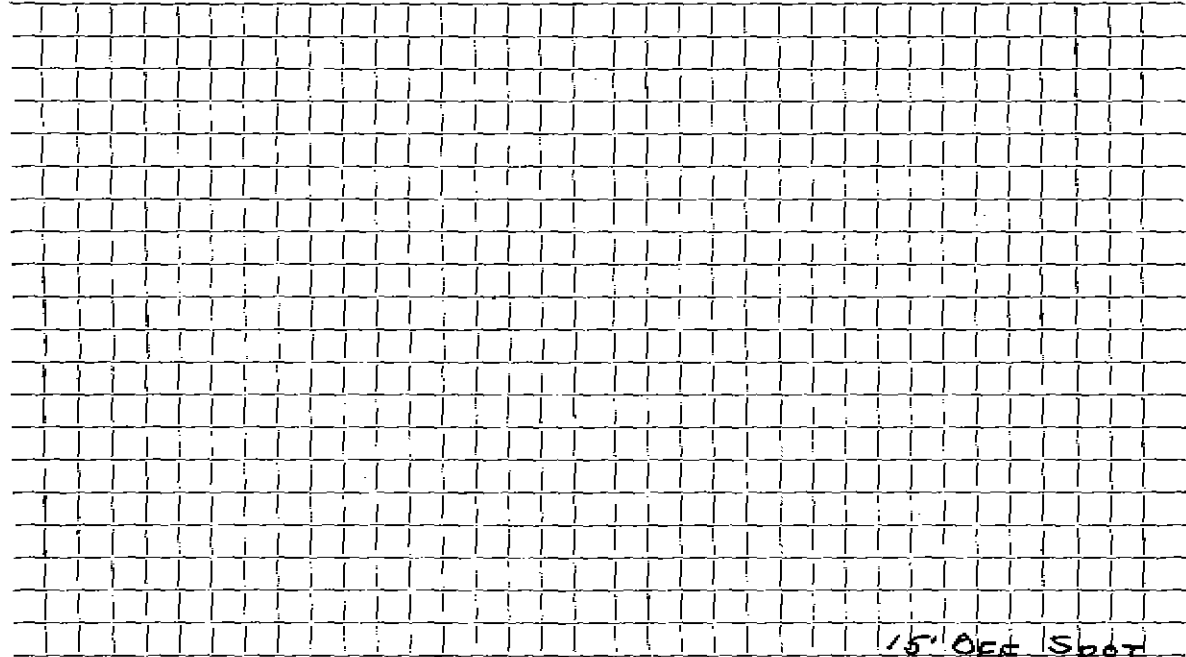

15' Off Spot

Connection made in ..... Street. Work completed .....

Remarks: .....  
.....  
.....