

Name Wakefield Garage Mfg. Co.

1279
Service No. ~~78~~ 973

Address Wakefield, Mass.
#16 Fottler Ave.

Location ^{#16} Annie Mason, Fottler Ave. cor Brandon St.

Kind of Pipe

Size

Size of Main

~~Repair - Renewal~~ - New Service

Location

Date	Material	Amount	Total	Date	Amount
------	----------	--------	-------	------	--------

12/3/30	34 1" C.L. Pipe @.27	9 18			
	3 1" L.L. Coup. @.25	75			
	2 1" L.L. Ells @.30	60			
	2 1" Br. Sp. Nip. @.25	50			
	1 S & W	3 00			
	Trucking	75	\$14 78		

Dec. 11 1930 Cash 14 78

Labor on sewer bill

Labor

4.495

Outside
24' - 3/4 Copper
1- 3/4 Corp. Adpt.
1- 3/4 Curb Stop
1- 3/4 x 1 Cop. Iron Adpt.
Box + Rod

28' 30.00

27
1370
13 50
27
50

DATE December 5, 1930

TOWN OF LEXINGTON—BOARD OF PUBLIC WORKS

WATER DIVISION

cor. Branson

416 Totten Ave.

The undersigned applies for a supply of water at No. 416 Totten Ave. St. and hereby agrees to comply with the rules and regulations as now, or at any future time, established by the Board of Selectmen.

Am't. of Estimate \$ _____

Owner

Annie Mason
Wald


Am't. Paid \$ _____

Address

159 A. Mass. Ave.
Boston.

Builder Wakefield Garage Mfg. Co.
Wakefield, Mass.

Sketch of Service Here

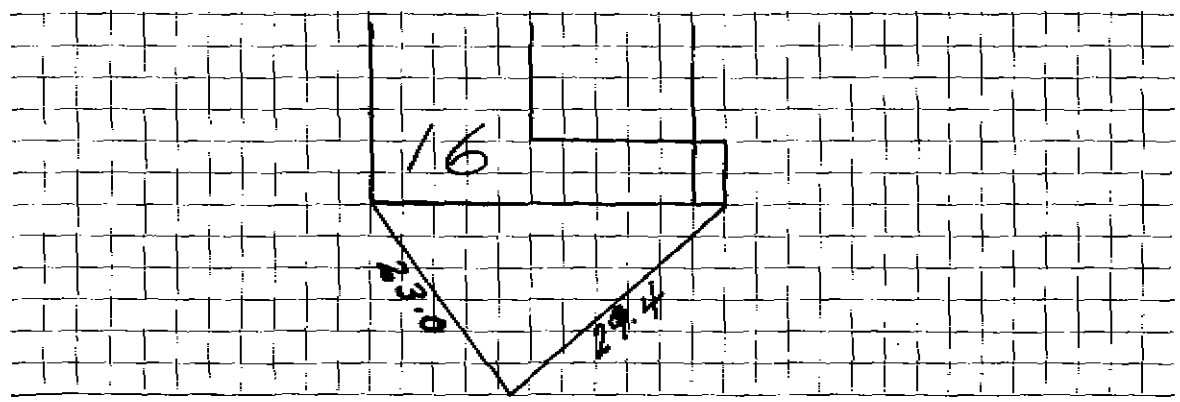

Connection made in _____ Street.

Work completed _____ 19

Remarks: