

Name James V. Piccariello

Service No. ~~974~~ #5601

Address 9 Shirley Street
22 Fottler Ave

Location 22 Fottler Ave. cor. Brandon St.

Kind of Pipe

Size

Size of Main

~~Repair or Renewal~~ - New Service

Location

Date	Material	Amount	Total	Date	Amount
6-23-00	31' 1" C.I. Pipe @.27	8 37			
9-15-31	1 1" L.L. Coup.	25			
	1 1" L.L. Ell	30			
	1 1" Br.S. Nipple	25			
	1 S & W	3 00			
	Trucking	75	12 92		
4/27/95	3/4 COPPER RENEWED			Aug. 17 1931 - Cash	63 -
8/22/31	7 Hrs. Labor @.55	3 85		checked	
	2 " " @.60	1 20	5 05	4-3-95	Outside
	15% Overhead		76		3/4 Copper
	<u>COST</u>		18 73		
	<u>CHARGE</u> 31' @ .75	\$23 25	\$23 25		
	Labor				
	Cost of sewer service charge to water in error		39 75		
			\$63 00		

Lexington
Winley Press, Inc.

DATE August 17, 1931

TOWN OF LEXINGTON—BOARD OF PUBLIC WORKS
WATER DIVISION

The undersigned applies for a supply of water at No. ³² Little Ave. Cor Brandon St. and hereby agrees to comply with the rules and regulations as now, or at any future time, established by the Board of Selectmen.

Am't. of Estimate \$ 63.00

Owner

James T. Carels


Am't. Paid \$ _____

Address

9 Shirley St.

Builder Frank J. Anditro

Sketch of Service Here

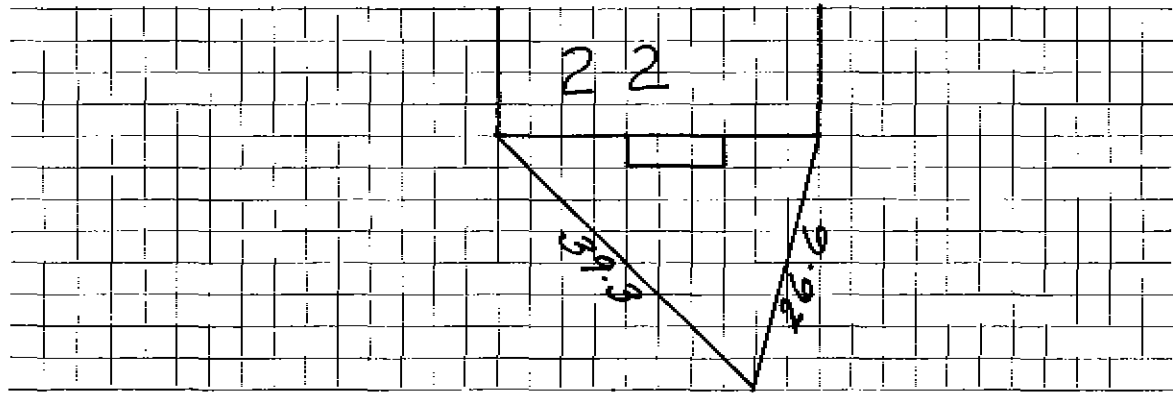

Connection made in _____ Street.

Work completed _____ 19

Remarks: