

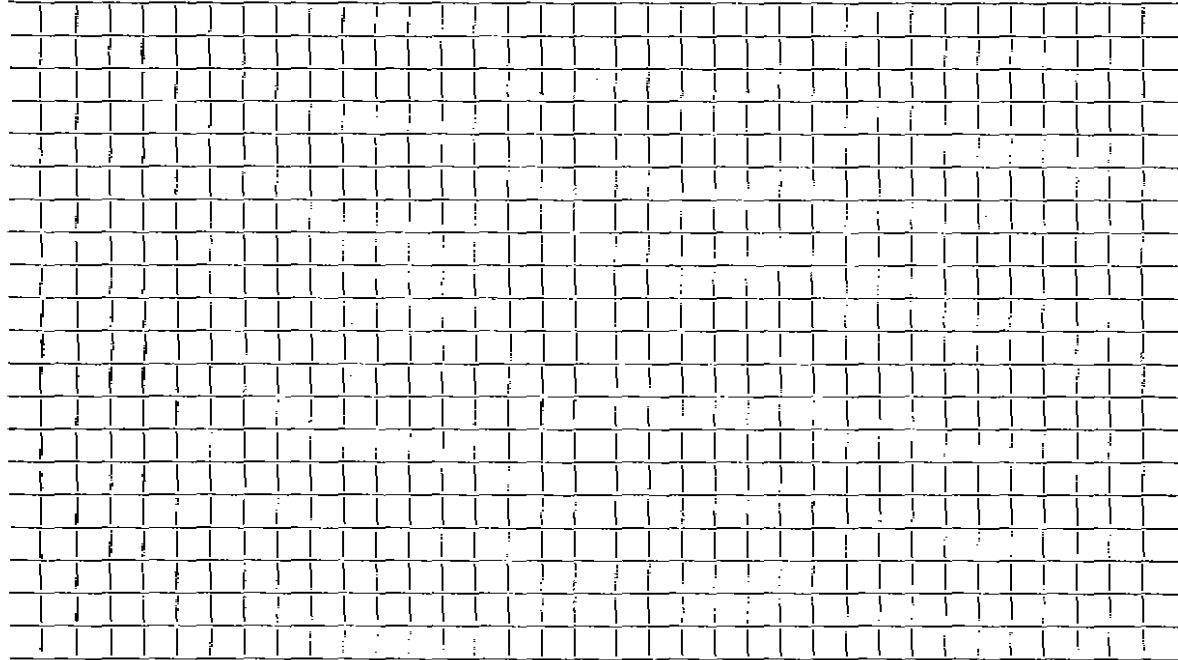


DATE \_\_\_\_\_

TOWN OF LEXINGTON — BOARD OF PUBLIC WORKS

**WATER DIVISION**

Sketch of Service Here

A large rectangular area filled with a grid of small squares, intended for drawing a sketch of service details.

Connection made in ..... Street.      Work completed .....

Remarks: .....  
.....  
.....