


Water Service Tie Card
TOWN OF LEXINGTON
 MASSACHUSETTS

33 Fottler Ave

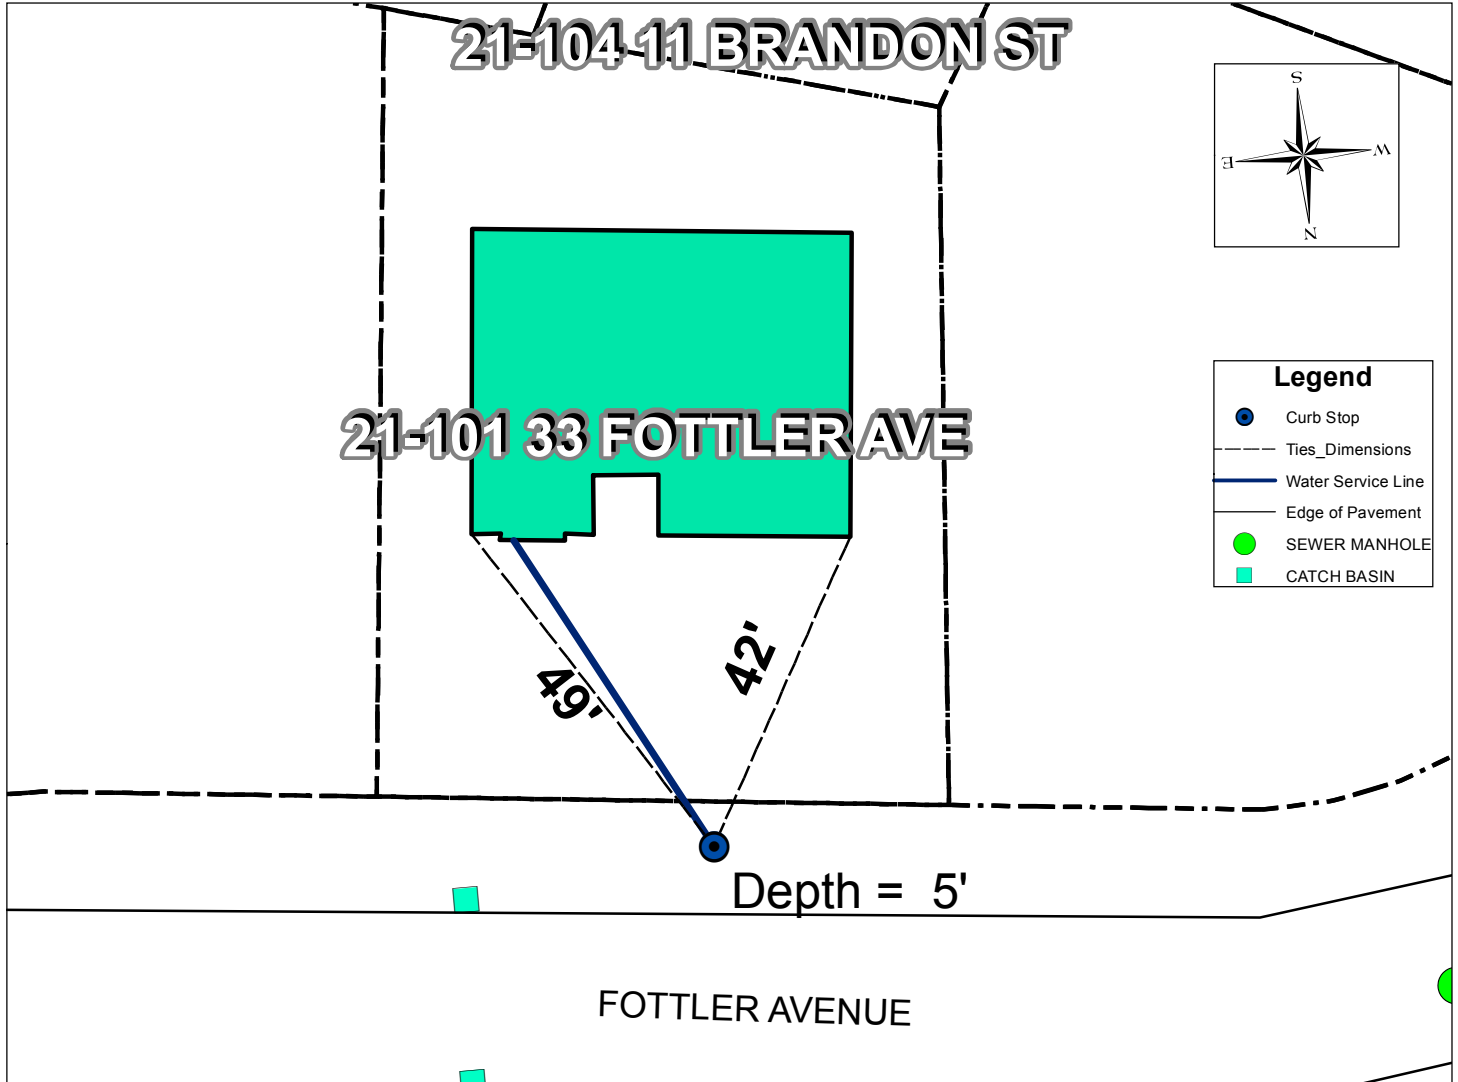

Address	Map and Lot	Permit Number	Contractor Name	Inspector
33 Fottler Ave	21-101	6360	McLaughlin, James M. Inc.	mflamang
Date	Material	Depth of Cover	Amount	
9/22/2015	1" Curb Valve and Buffalo Box 1" Copper type "k"	5 ft	1 45 ft to HSE	
Type of work completed				

New 1" water service to house from curb stop. New house on lot old house removed.