

Name Marion M. Poitras  
 Marjorie Road  
 Address Wilmington, Massachusetts  
 #35 Fottler Ave.

Service No. ~~#~~ 976  
 #6408

Location 35 Fottler Avenue

Kind of Pipe Size Size of Main

~~Repair~~ ~~Renewal~~ - New Service

Location

Date  
 1939

Material

Amount

Total

Date

Amount

Sept. 12,  
 Com  
 10/30/39.

2 hrs. @ 60¢  
 10% Overhead  
 29' 3/4" Copper Tubing @ 15¢  
 1 3/4" S. & W.  
 Trucking 2 hrs. @ 75¢

1 20  
 12  
 4 35  
 2 10  
 1 50  
 9 27  
 15 00

September 5, 1939 Deposited

15 00

Flat rate:

Labor

DATE \_\_\_\_\_

# TOWN OF LEXINGTON—BOARD OF PUBLIC WORKS

## WATER DIVISION

The undersigned applies for a supply of water at No. \_\_\_\_\_ St. and hereby agrees to comply with the rules and regulations as now, or at any future time, established by the Board of Selectmen.

Am't. of Estimate \$ \_\_\_\_\_


Owner \_\_\_\_\_

Am't. Paid \$ \_\_\_\_\_

Address \_\_\_\_\_

Builder \_\_\_\_\_

Sketch of Service Here

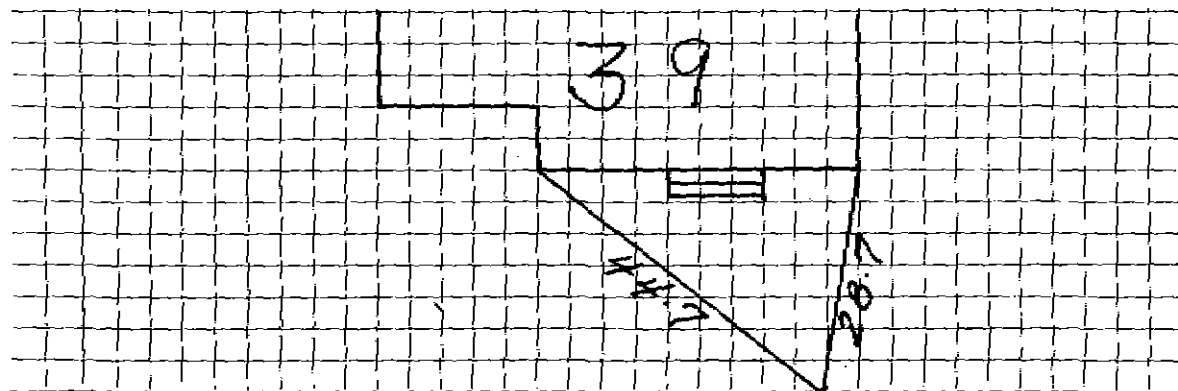

Connection made in \_\_\_\_\_ Street.

Work completed \_\_\_\_\_ 19

Remarks:

Name Marion M. Poitras  
 Marjorie Road  
 Address Wilmington, Massachusetts  
 #35 Fottler Ave

Service No. ~~#~~ 976  
 #6406

Location 35 Fottler Avenue

Kind of Pipe Size Size of Main

~~Repair-Renewal~~ - New Service Location

Date	Material	Amount	Total	Date	Location	Amount
1939						
Sept. 12, <i>Coins</i> <i>10/30/39</i>	2 hrs. @ 60¢		1 20	September 5, 1939	Deposited	15 00
	10% Overhead		12			
	29' 3/4" Copper Tubing @ 15¢		4 35			
	1 3/4" S. & W.		2 10			
	Trucking 2 hrs. @ 75¢		1 50			
			<u>9 27</u>			
	Flat rate:		15 00			
	Labor					

Hadley Press, Inc., Lexington

DATE Sept 5 1939

# TOWN OF LEXINGTON—BOARD OF PUBLIC WORKS

## WATER DIVISION

The undersigned applies for a supply of water at No. 35 Fatten Ave St. and hereby agrees to comply with the rules and regulations as now, or at any future time, established by the Board of Selectmen.

Am't. of Estimate \$ \_\_\_\_\_

Owner

Marion M. Poitcast

Am't. Paid \$ \_\_\_\_\_


Address

Marjorie Rd  
Wilmington

Builder

F. G. Poitcast

Sketch of Service Here

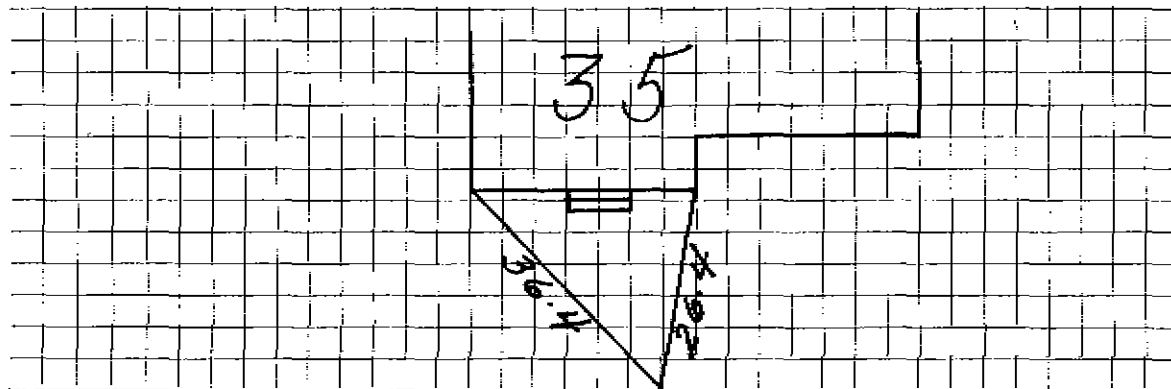

Connection made in \_\_\_\_\_ Street.

Work completed \_\_\_\_\_ 19

Remarks: