

Name Frank G. Poitras

Service No. ~~65~~ 977

Address Marjoire Road, Wilmington, Mass.
39 Fottler Ave.

Location #39 Fottler Avenue

Kind of Pipe

Size

Size of Main

Repair—Renewal—New Service

Location

Date
1938

Material

Amount

Total

Date

Amount

Dec. 2

2 hrs. @ 30¢

1 20

Dec. 2, 1938

Deposited

16 00

Com 12/14/38

32' 3/4" Cop. Tapping @ 20¢

6 40

1 3/4" S. & W.

3 75

2 hrs. trucking @ 75¢

1 50

12 85

Flat Rate: \$13.00

Labor

DATE _____

TOWN OF LEXINGTON—BOARD OF PUBLIC WORKS

WATER DIVISION

The undersigned applies for a supply of water at No. _____ St. and hereby agrees to comply with the rules and regulations as now, or at any future time, established by the Board of Selectmen.

Am't. of Estimate \$ _____


Owner _____

Am't. Paid \$ _____

Address _____

Builder _____

Sketch of Service Here

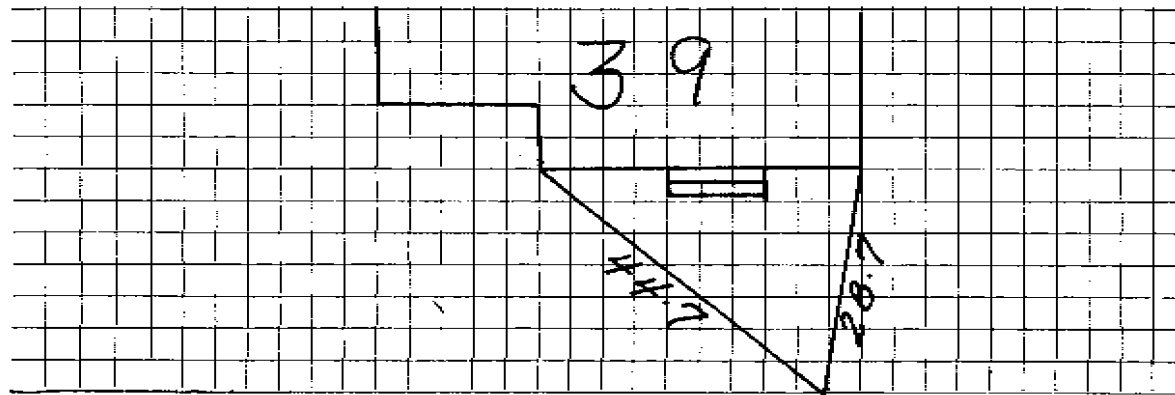

Connection made in _____ Street.

Work completed _____ 19

Remarks: