

WATER SERVICE RECORD

Name Nicholas Ruocco

Service No. 170 #1008

Address 45 Fottler Avenue

Location Lexington

~~Repair - Renewal~~ New Service

Com 11-3-52

Date	Material	Amount	Total	Date	Amount
9/25/52	Labor	1 63		8-13-52	Deposited 25 00
	10% Overhead	16	1 79	11-3-52	Paid (1 94)
	60' - 3/4" Copper tubing@.34	20 40			NON CHARGE 26 94
	1 - 3/4" C x 1/2 I.W.H. stop&waste	4 00		9/25/52	Labor 1 63
	1 hr. trucking		75	27' - 3/4" Copper tubing@.34	9 18
			26 94	1 - 3/4" C. Corp-cock	4 33
				1 - 3/4" C c 3/4" C. curb-cock	4 67
				1 box and rod	3 90
				1 - 1/2 straight tail piece	50
				1 - 3/4 offset tail piece	50
				1 hr. trucking	75
					25 46

DATE _____

TOWN OF LEXINGTON - BOARD OF PUBLIC WORKS

WATER DIVISION

The undersigned applies for a supply of water at No. St. and hereby agrees to comply with the rules and regulations as now, or at any future time, established by the Board of Selectmen.

Am't of Estimate \$.....

Owner

Am't Paid \$.....


Address

Builder

.....

Sketch of Service Here

FOTTER AVE

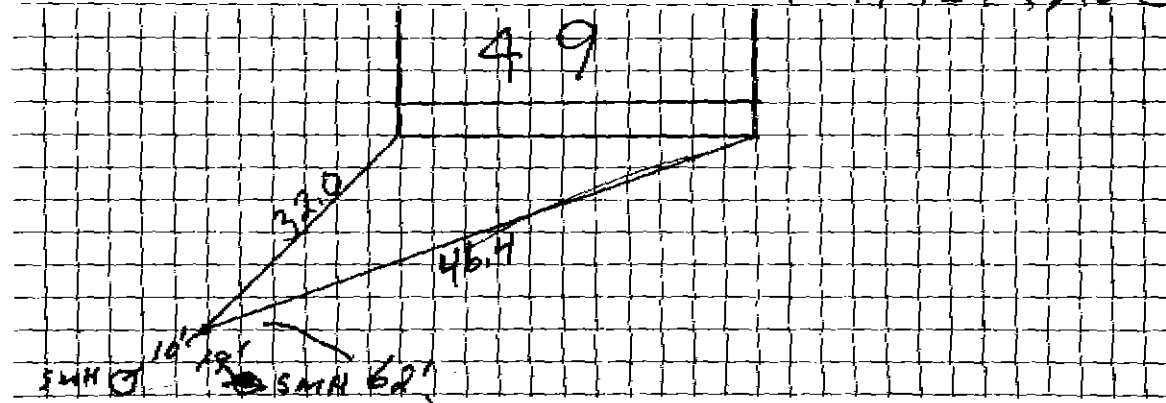

Connection made in Street.

Work completed19

Remarks:

Hyd