

WATER SERVICE RECORD

Name Louise G. Finney

Service No. 18 N.D.

Address 52 Fottler Avenue

Location

~~Repair~~—Renewal—~~New Service~~ W. O. # 8133

APR 26 1972


Date		Material	Amount	Total	Date	Amount
9/23/71		Labor	30 44		7-22-72	Paid 91 78
	10%	O.H.	3 04	33 48		
	50'	3/4" Copper pipe .79		39 50		
	1	3/4" Wheel Valve		9 30		
	1	Hr. Shovel		6 50		
				91 78		
					9/23/71	Labor 90 18
					11/4/71	" 45 62
					10'	3/4" Copper pipe .79 7 90
					1	3/4" Adaptor 2 76
						Box & Rod 5 10
					1/2	Ton cold patch 8.00 2 00
					3/8"	Curb stop 8 57
					2 1/2	Ton hot top 7.45 18 63
					2	Hrs. Shovel 4.00 8 00
					2	" Truck 3.00 6 00
					1	" Compressor 3 00
					1/2	" Roller 2.00 1 00
						Trailer 2 00
						200 76

DATE _____

TOWN OF LEXINGTON — BOARD OF PUBLIC WORKS

WATER DIVISION

Sketch of Service Here

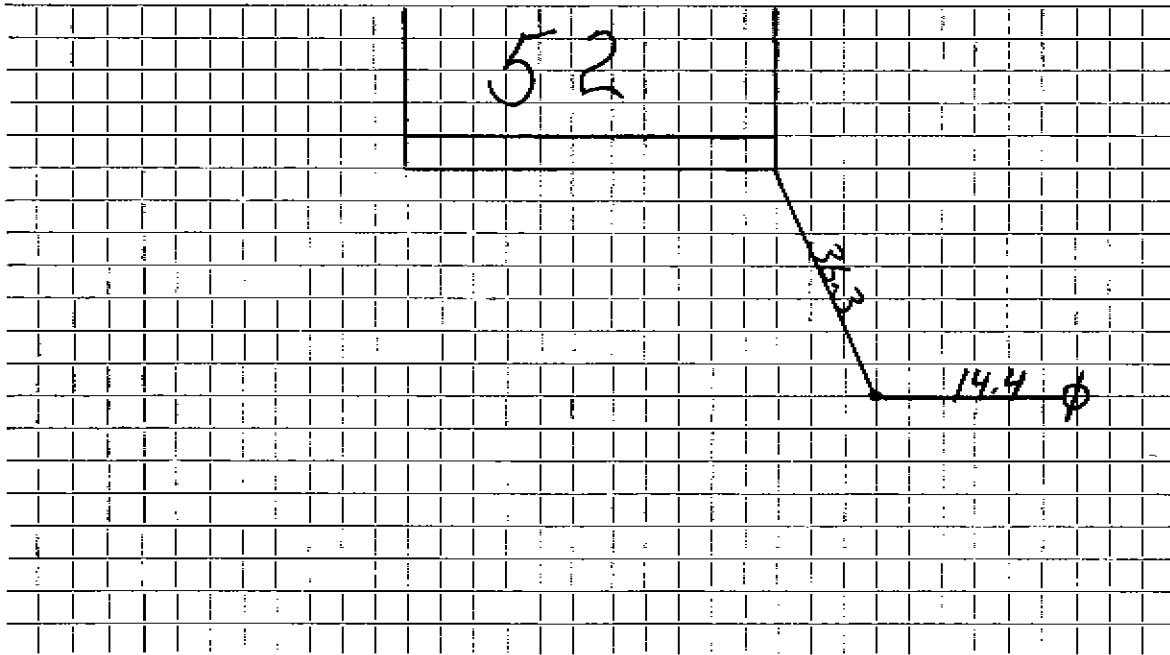

Connection made in Street. Work completed

Remarks:
.....
.....