

## WATER SERVICE RECORD

Name Louis Rosendorn

Service No. 337 (1956)

Address 66 Fottler Avenue

Location

~~REPAIR WORK~~ New Service

Comm. 2-25-57


Date	Material	Amount	Total	Date	Amount
11/14/56	Labor	1 90		11-5-56	Deposit \$ 40 00
	10% overhead	19	2 09	2/25/57	Refund 11 10
	48' - 3/4" Copper tubing @ .4396	21 10			NON CHARGE \$ 28 90
	1 - 3/4" Cx 1/2 I.W.H. Stop & Waste	4 96		Labor	1 90
	1 hr. trucking		75	10' - 3/4" Copper tubing @ .4396	4 40
			28 90	1 - 3/4" C. Corp Cock	4 64
				1 - 3/4" C. Curb Cock	5 94
				1 Box & Rod	4 62
				1 - 1/2" Straight tailpiece	50
				1 - 1/2" Offset tailpiece	50
					22 50
				11-13-58	
					6" tapped vapour
					1 3/4" corp
					1 3/4" union (955 @)
					2' 3/4" copper

DATE \_\_\_\_\_

TOWN OF LEXINGTON — BOARD OF PUBLIC WORKS

**WATER DIVISION**

Sketch of Service Here

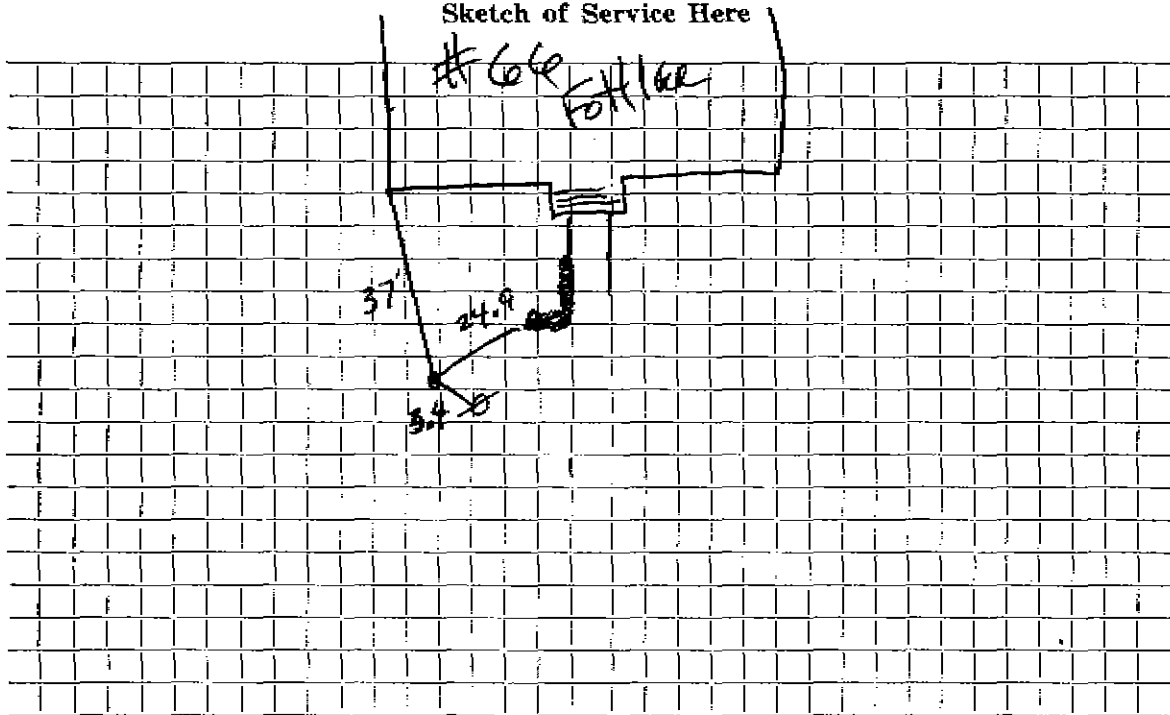

Connection made in ..... Street. Work completed .....

Remarks: .....  
.....  
.....