

WATER SERVICE RECORD

Name Wesley Nelson

Service No. 145

Address 67 Fottler Avenue

Location

~~Record Renewal~~ - New Service W.O. #8359


MAR 23 1964

Date	Material	Amount	Total	Date	Amount
12-10-63	Labor	2 31		12-2-63	Deposit 25.00
	10% O.H.	23	2 54	3-27-64	* Refund 41.89
60'	3/4" Copper Tubing @.42		25 20		33.91
1	3/4" CX 1/2 I.W.H. Stop & Waste		6 17		
			33 91		NON CHARGE
				12-10-63	Labor 2 31
					26' 3/4" Copper Tubing @.42 10 92
					1 3/4" Corp Cock 4 19
					1 3/4" C Curb Cock 6 28
					1 Box & Rod 4 90
					1 1/2 Straight Tailpiece 50
					1 1/2 Offset Tailpiece 50
					29 60

* Apply 32.21 to 5/10/64 209

TOWN OF LEXINGTON — BOARD OF PUBLIC WORKS
WATER DIVISION

Sketch of Service Here

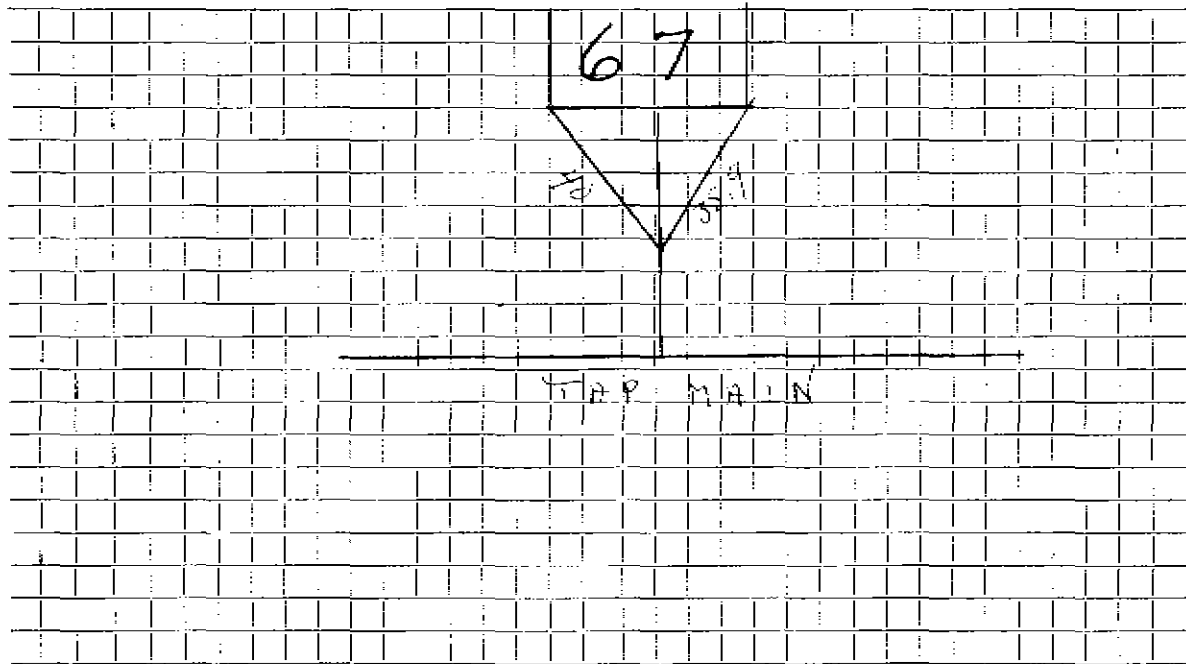

Connection made in Street. Work completed

Remarks:

.....

.....