

WATER SERVICE RECORD

Name

Service No.

Address

82 Fottler Avenue

Location

Repair—~~Renewal~~ ~~New Service~~

(leak at curb)


Date	Material	Amount	Total	Date	Amount
3/3/87	4' 6"	3/4" Copper			
		1" Copper to House			
					<i>OUTSIDE</i>
				3/3/87	9' 3/4" Copper
					1 3/4 x 5/8 LF Adaptor
					1 3/4" Curb
					<i>Box & Rod</i>

DATE _____

TOWN OF LEXINGTON — BOARD OF PUBLIC WORKS

WATER DIVISION

Sketch of Service Here

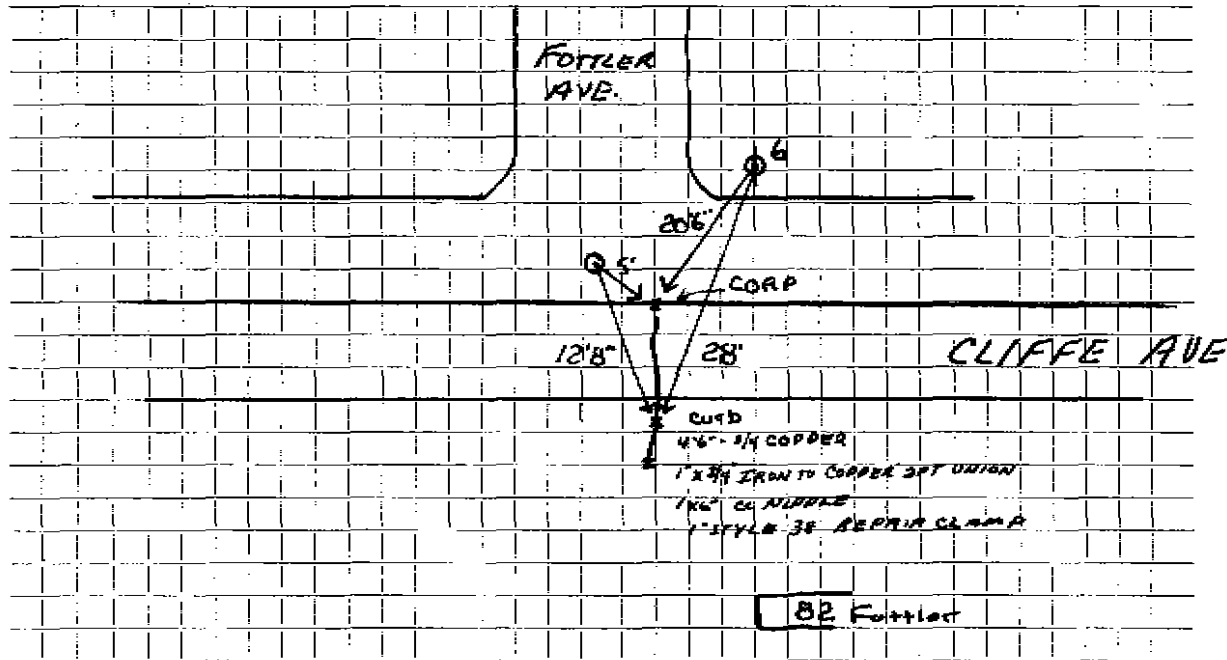

Connection made in Street. Work completed

Remarks:
.....
.....