




DATE APRIL 25, 1997

TOWN OF LEXINGTON — BOARD OF PUBLIC WORKS  
WATER DIVISION

Sketch of Service Here

#12 FOX RUN LANE

\*FOUNDATION NOT  
INSTALLED AT  
TIME OF  
INSPECTION.  
APRIL 25, 1997

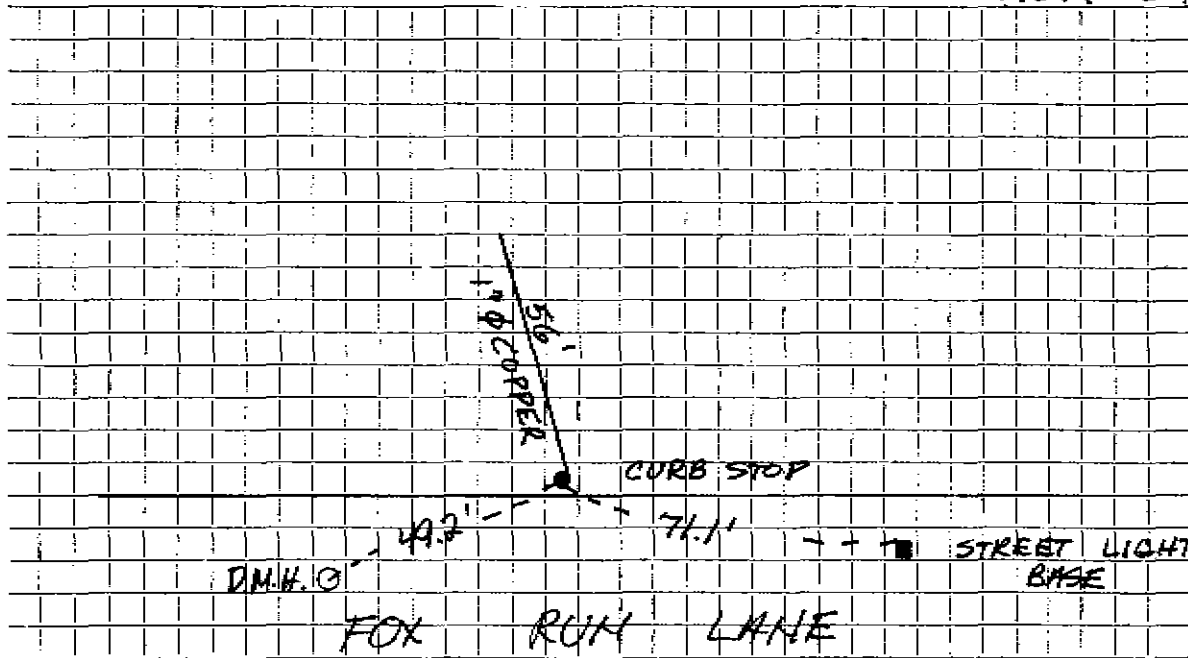

Connection made in FOX RUN LANE Street.

Work completed A. CARDILLO & SONS

Remarks: .....