




DATE 6/20/96

TOWN OF LEXINGTON — BOARD OF PUBLIC WORKS  
**WATER DIVISION**

Sketch of Service Here

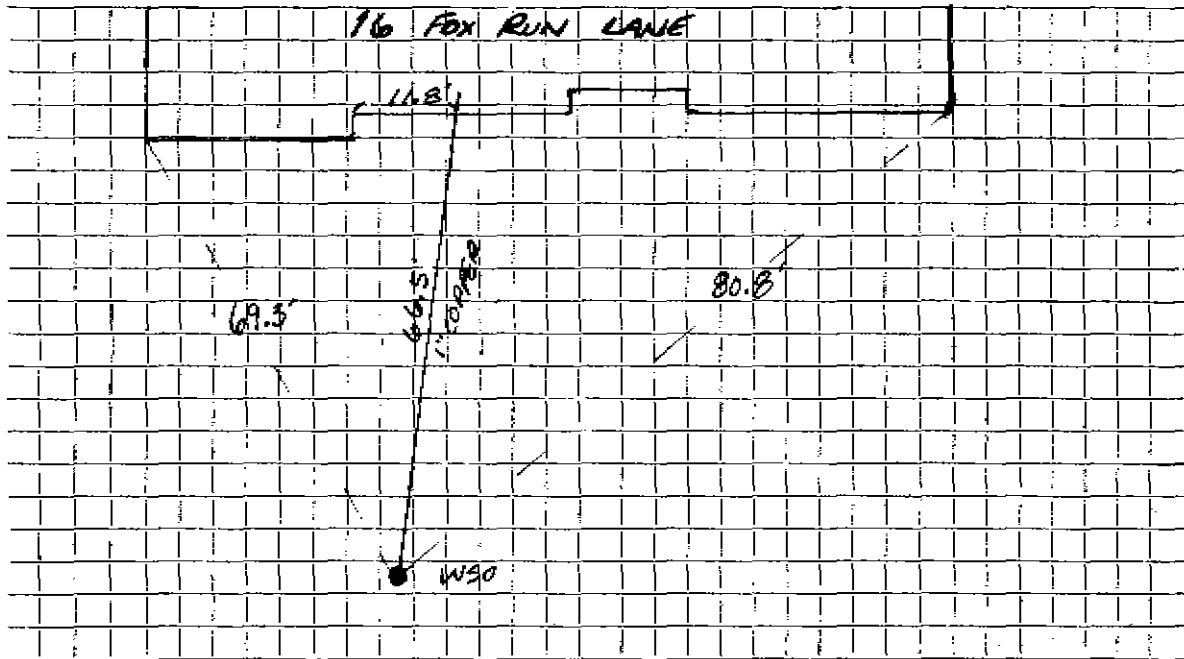

Connection made in FOX RUN LANE Street. Work completed A. CARDILLO & SONS

Remarks: .....

BOOK 96-2