

WATER SERVICE RECORD

Name

Service No.

Address 18 FOX RUN LN.

Location

Repair—Renewal—**New Service**


Date	Material	Amount	Total	Date	Amount
6/6/96	61 LF 1" COPPER				
	1" UNION				
	WSD				

DATE 6/6/96

TOWN OF LEXINGTON — BOARD OF PUBLIC WORKS

WATER DIVISION

Sketch of Service Here

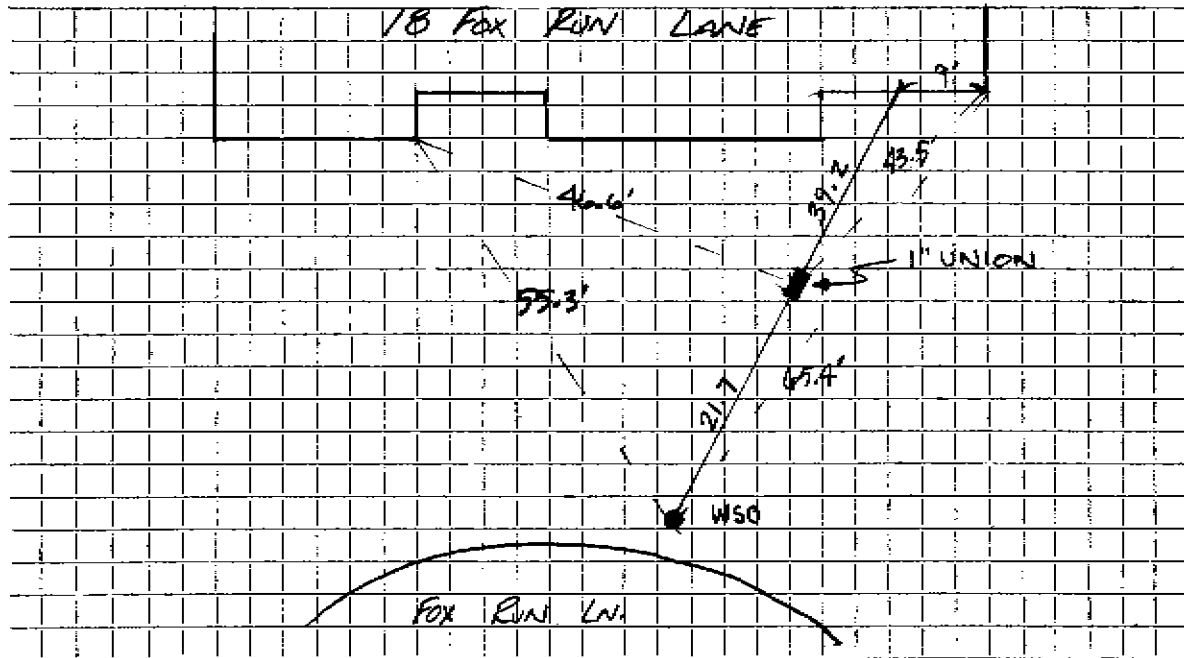

Connection made in FOX RUN LN. Street. Work completed A. CARDILLO & SONS

Remarks:

.....

.....