


DATE 24 SEPT. 1996

TOWN OF LEXINGTON — BOARD OF PUBLIC WORKS
WATER DIVISION

Sketch of Service Here

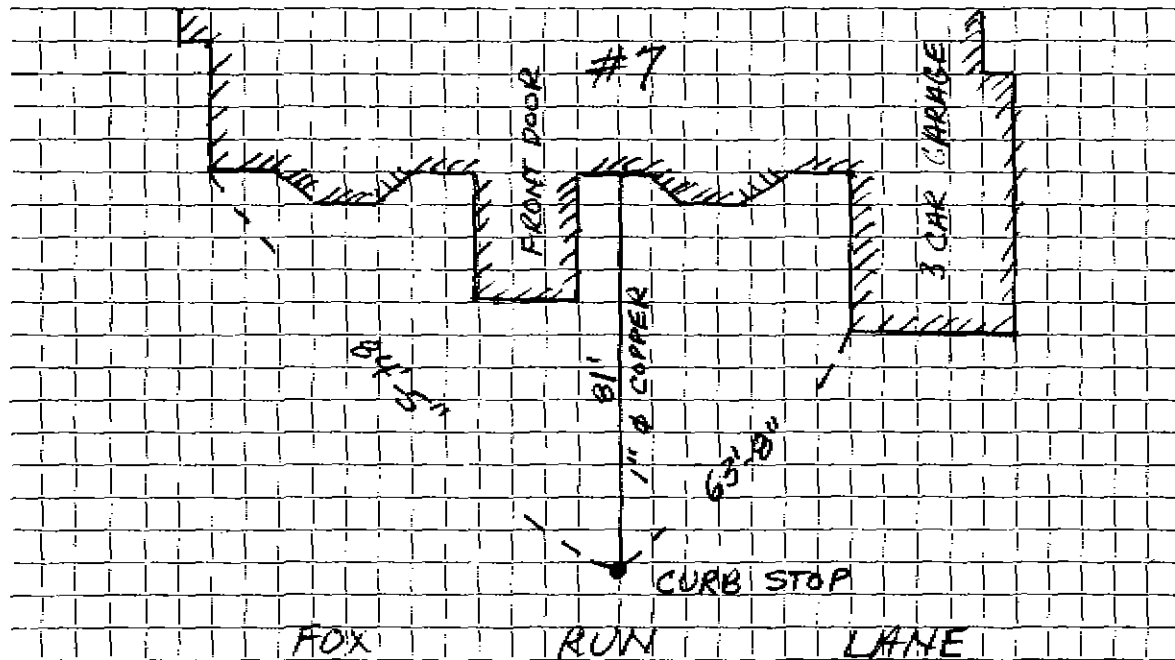

Connection made in FOX RUN LANE Street.

Work completed A. CARDILLO & SONS

Remarks:

BOOK 96-4

J.W.