




DATE JULY 1 1998

TOWN OF LEXINGTON — BOARD OF PUBLIC WORKS

WATER DIVISION

Sketch of Service Here

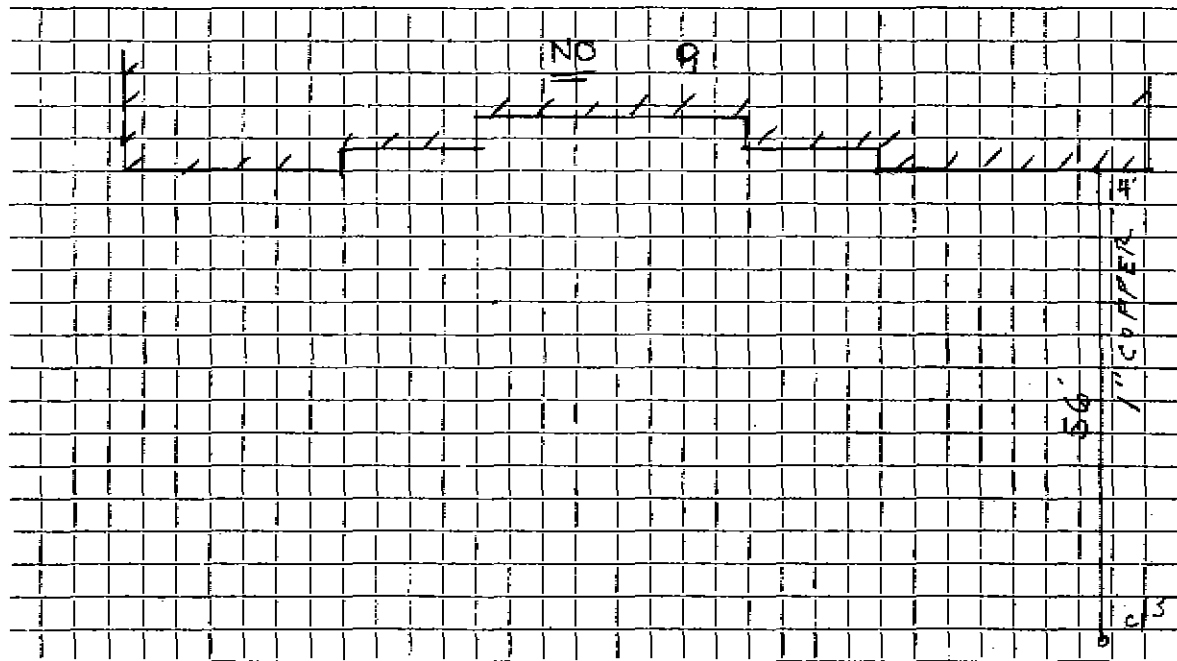

Connection made in FOXRUN LANE Street.

Work completed A. CARDILLO & SONS

Remarks: .....

FIELD BOOK 98-2

TJM