

WATER SERVICE RECORD

Name Herbert McConchie

Service No. 168

Address 1 Frances Road

556

Location

Repair—Renewal—New Service

Comm 12-18-61


Date	Material	Amount	Total	Date	Amount
10/27/61	Labor	2 04		10-26-61	Deposit 75 00
	10% O.H.	20	2 24	12-18-61	Refund 43 60
	49' 3/4" Copper Tubing @ .42		20 58		31 40
	1 3/4" C X 1/2 IWH Stop & Waste		6 17		
	1 3/4" C 3 Part Union		2 41	10/27/61	Labor 2 04
			31 40		12' 3/4" Copper Tubing @ .42 3 04
					1 3/4" C Curb Cock 6 28
					1 3/4" C Corp Cock 4 91
					1 Bow & Rod 4 90
					1 1/2 Straight Tailpiece 50
					1 1/2 Offset Tailpiece 50
					24 17

DATE _____

TOWN OF LEXINGTON — BOARD OF PUBLIC WORKS

WATER DIVISION

Sketch of Service Here

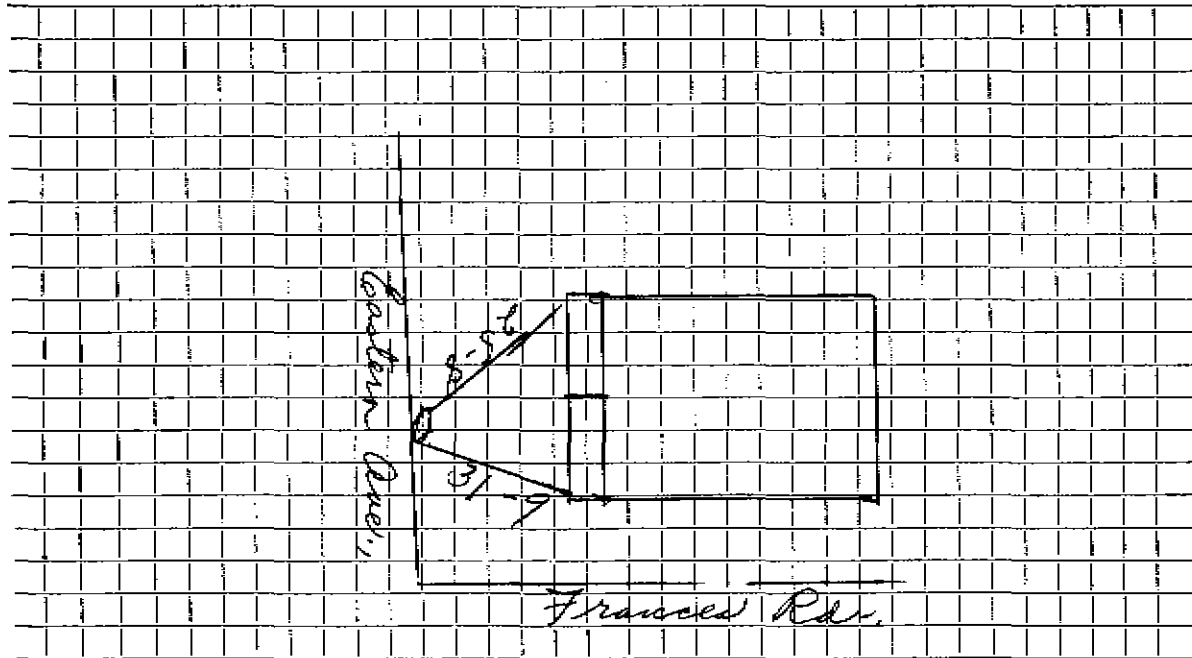

Connection made in _____ Street. Work completed _____

Remarks: _____
