

WATER SERVICE RECORD

#5584

Name Charles H. Murray

Service No. 88

Address 11 Francis Road

#7476

Location Lot #131 4th 130

Repair—Renewal—New Service


Comm 7-17-61

Date	Material	Amount	Total	Date		Amount
7-6-61	Labor	2.04		6-29-61	Deposit	50 00
	10% O.H.	.20	2.24	7-17-61	Refund	19 69
45'	3/4" Copper Tubing @.42		18.90			30 31
1	3/4" C x 1/2 I.W.H. Stop & Waste	6.17			NON CHARGE	
1	Hr. Trucking @3.00	3.00	3.00	10-24-59	Labor	3 70
			30.31	8'	3/4" Copper tubing @.41	3 28
				1	3/4" C Corp Cock	4 64
				1	3/4" C Curb Cock	5 94
				1	Box & Rod	5 00
				1	Hr. Trucking	75
						24 13
				7-6-61	1 1/2 Straight tailpiece	.50
					1 1/2 Offset tailpiece	.50
						25.13

TOWN OF LEXINGTON — BOARD OF PUBLIC WORKS

WATER DIVISION

Sketch of Service Here

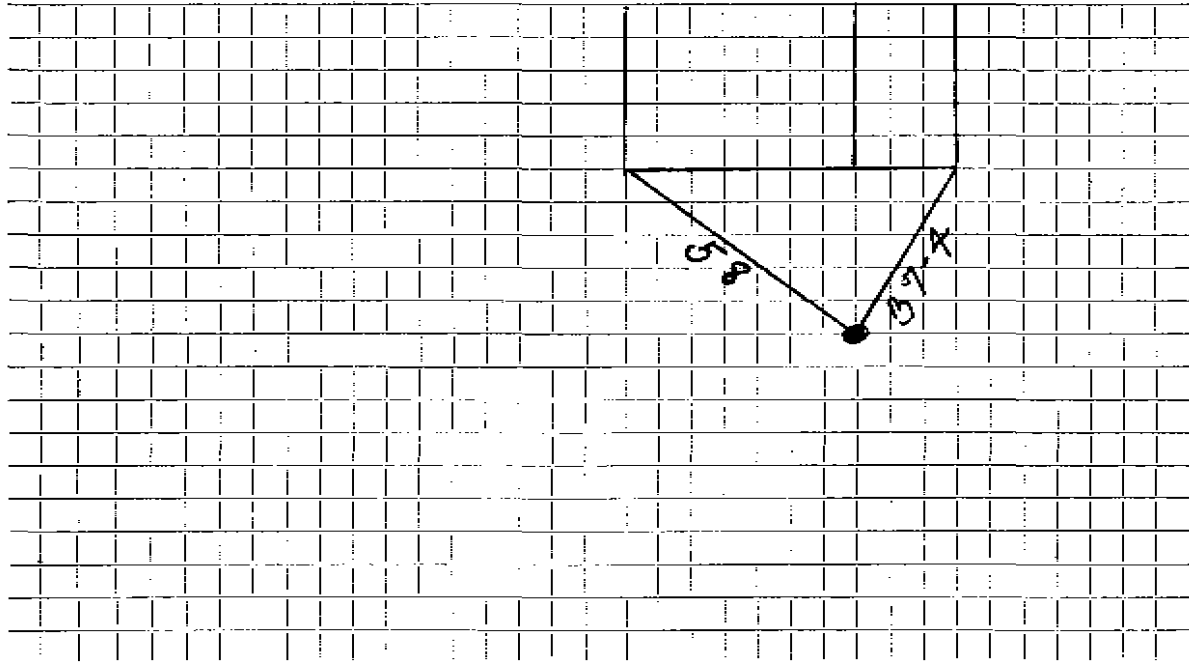

Connection made in Street. Work completed

Remarks:

.....

.....