

WATER SERVICE RECORD

Name Charles H. Murray

Service No. 299

Address 15 Francis Road

Location Lot # 128 & 127

~~Repair~~ - New Service


Comm 3-6-61

Date	Material	Amount	Total	Date	Material	Amount
12-7-60	Labor	3.63		12-6-60	Depos. 4	25 00
	135 G.H.	.36	3.99	6-30-64	Paid	8 94
45'	3/4" Copper tubing @.42		18.90			3.3 94
1	3/4" C x 1/2 I.W.E. Stop & Waste		6.17		NON CHARGE	
1	Curb Box & Rod		4.80	10-24-59	Labor	3 70
			33.86		10' 3/4" Copper tubing @.41	4 10
					1 3/4" C Corp Cock	4 64
					1 3/4" C Curb Cock	5 94
					1 Box & Rod	5 00
					1 Hr. Trucking	75
						24 13
					1 1/2 Straight tailpiece	.50
					1 1/2 Offset tailpiece	.50
						25.13

DATE _____

TOWN OF LEXINGTON — BOARD OF PUBLIC WORKS
WATER DIVISION

Sketch of Service Here

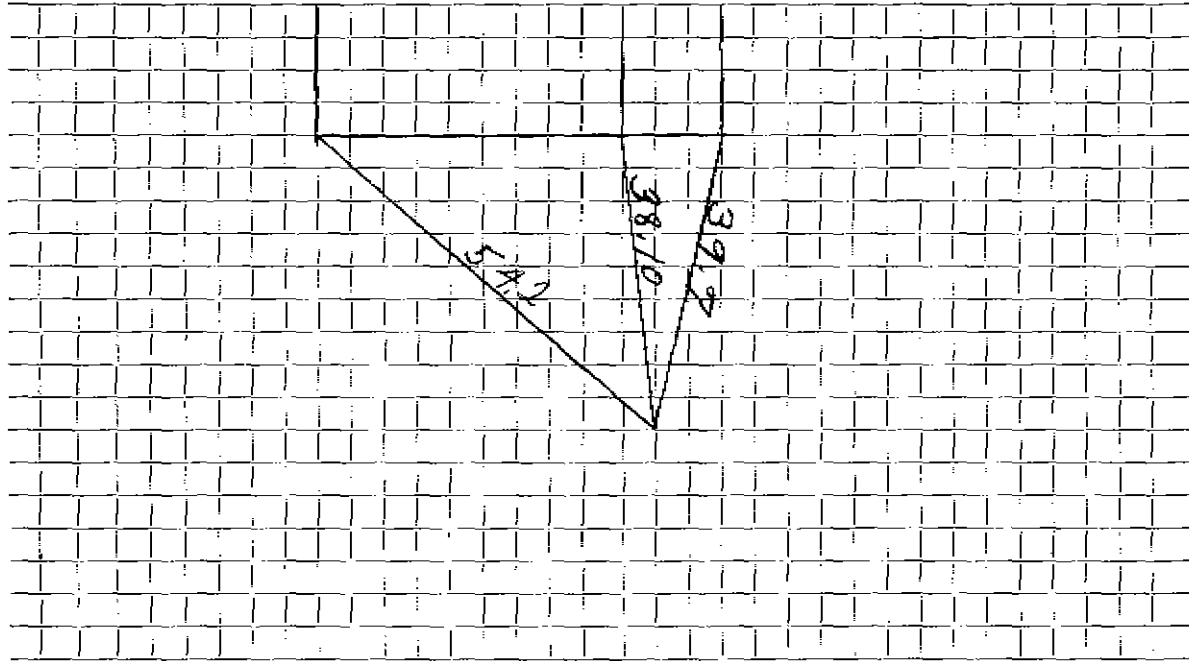

Connection made in Street. Work completed

Remarks:
.....
.....