

WATER SERVICE RECORD

Name Charles H. Murray

Service No. 119

Address 17 Francis Road

2295

Location Lot # 126 & 127


~~Repair~~ ~~Renewal~~ New Service

Conn 8-22-60

Date	Material	Amount	Total	Date	Amount	
7-31-60	Labor	2 05		7-21-60	Deposit	35 00
	10% O.E.	21	2 26	8-22-60	Paid by S# 123	6 50
73'	3/4" Copper tubing @.42		30 66			41 50
1	3/4" Gxg T.E.F. Stopwaste		6 17		NON CHARGE	
1	3/4" G3 part Union		2 41	10-24-59	Labor	3 70
			41 50		10' 3/4" Copper tubing @.41	4 10
					1 3/4" C Corp Cock	4 64
					1 3/4" C Curb Cock	5 94
					1 Box & Rod	5 00
					1 Hr. Trucking	75
						24 13
					1 1/2 Straight tailpiece	50
					1 1/2 Offset tailpiece	50
						25 13

TOWN OF LEXINGTON — BOARD OF PUBLIC WORKS
WATER DIVISION

Sketch of Service Here

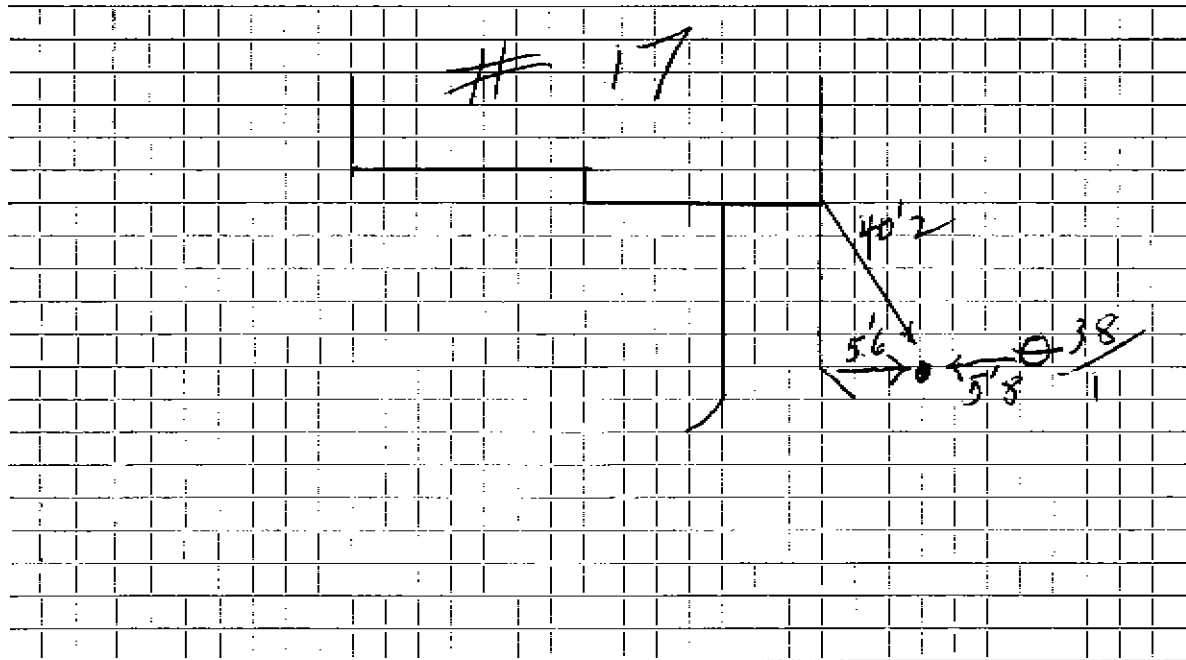

Connection made in Street. Work completed

Remarks:

.....

.....