2.3.M.25020

WATER SERVICE RECORD

#4202

Name

Service No.

Address

18 Frances Road

Location

Repair-Renewal-New Service


	Material	Amount	Total	Date	Amou
1 ;					
		- 	 		
			 		
			 		
			; -		
			 	- 	
·			<u> </u>	·	
			ļ	,	
	<u></u>		! 		
, l		· · · · · · · · · · · · · · · · · · ·	l		ļ ļ
			Ţ		
_ 	_ _		 	- 	
			ļ ————————————————————————————————————	-H	
		- -		-	
			· 		
	-	· - 	}		
' +			<u></u>	#	
			<u> </u>	 - #	·
			\ <u> </u>	······································	·
				п — — — — — — — — — — — — — — — — — — —	

D.	A	T	Ε	 	 	 	 	

TOWN OF LEXINGTON - BOARD OF PUBLIC WORKS

WATER DIVISION

Sketch of Service Here

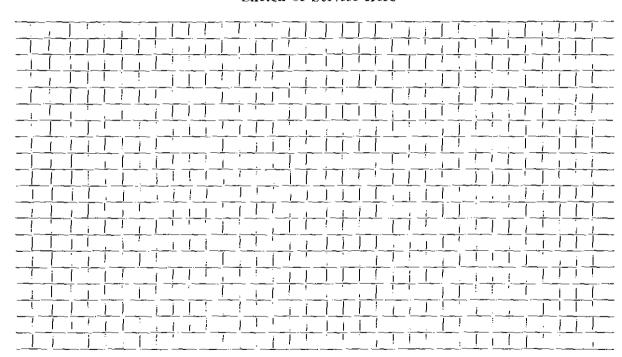

Connection made in	. Street.	Work completed
Remarks:		