

WATER SERVICE RECORD

5113

Name Herbert McConchie

Service No. 201

Address 3 Frances Road

Location

~~Repair - Remedy~~ - New Service

Comp 10-24-60


Date	Material	Amount	Total	Date	Amount
9-23-60	Labor	1.84		9-24-60	30 00
	10' C.H.	.19	2.03	10-24-60	2.77
	41' 3/4" Copper tubing	17.22	17.22		27.93
	1 3/4" C x 1/2 I.P.F. Stop & Waste	6.07	6.07		NON CHARGE
	1 3/4" C 3 part union	2.41	2.41	1 1/2 Straight tailpiece	.50
			27.93	1 1/2 Offset tailpiece	.50
					1.00

DATE _____

TOWN OF LEXINGTON — BOARD OF PUBLIC WORKS

WATER DIVISION

Sketch of Service Here

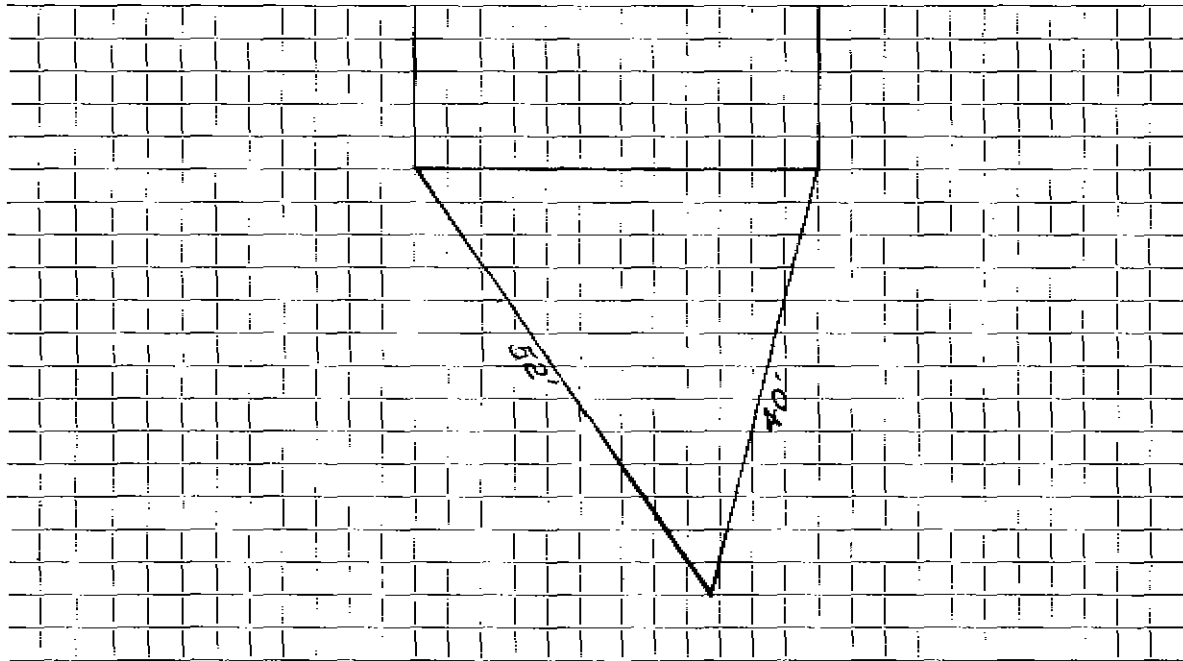

Connection made in Street. Work completed

Remarks:

.....

.....