

WATER SERVICE RECORD

Name Charles E. Murray

Service No. 265

Address 8 Franc~~is~~ Road

Location Lot # 574-55


~~Repair~~ ~~Renewal~~ - New Service

Jan 12-21-59

| Date | Material | Amount | Total | Date | Amount |
|----------|----------------------------------|--------|-------|----------|-------------------------------|
| 10-21-59 | Labor | 1 85 | | 10-16-59 | Deposit 50 00 |
| | 10% O. H. | 19 | 2 04 | 12-21-59 | Returned 9 24 |
| 71 | 3/4" Copper tubing @.42 | | 29 82 | | 41 76 |
| 1 | 3/4" C x 1/2 I.W.H. Stop & Waste | 5 | 88 | | NON CHARGE |
| 1 | 3/4" C 3 part Union | 2 | 27 | 10-21-59 | Labor 1 85 |
| 1 | Hr. Trucking @.75 | | 75 | 26 | 3/4" Copper tubing @.42 10 92 |
| | | | 40 76 | 1 | 3/4" C Core Cock 4 67 |
| | | | | 1 | 3/4" C Curb Cock 5 98 |
| | | | | 1 | Box & Rod 4 90 |
| | | | | 1 | 1/2 Straight Tailpiece 50 |
| | | | | 1 | 1/2 Offset Tailpiece 50 |
| | | | | | 29 32 |

TOWN OF LEXINGTON — BOARD OF PUBLIC WORKS
WATER DIVISION

Sketch of Service Here

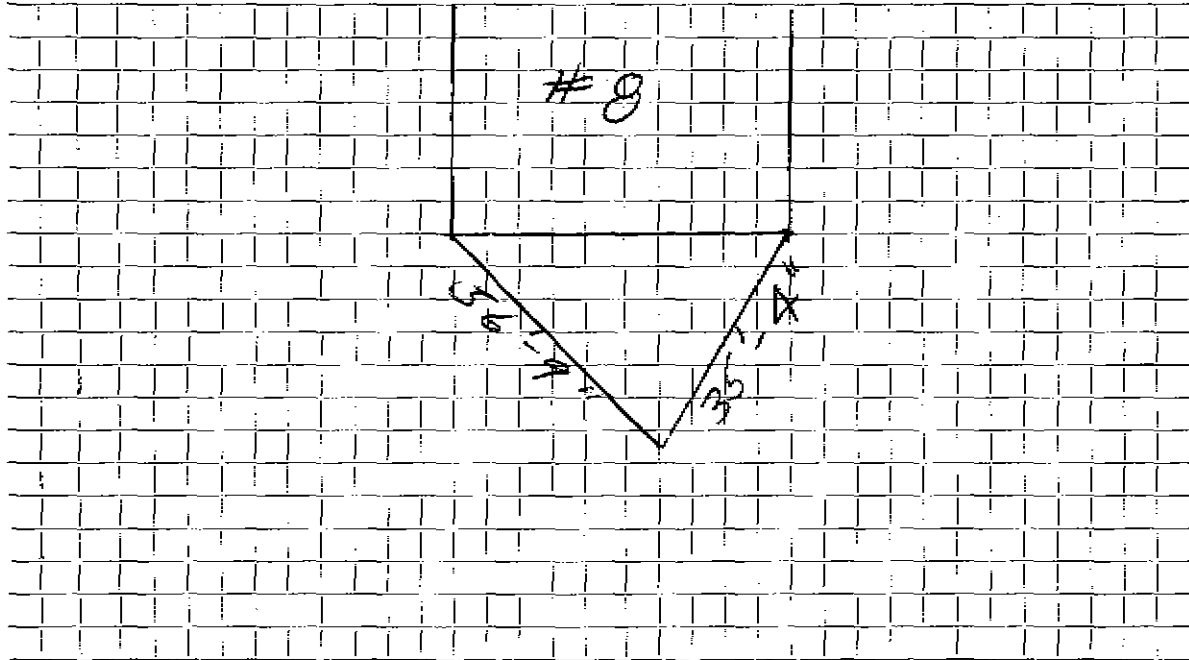

Connection made in Street. Work completed

Remarks:

.....
.....