

WATER SERVICE RECORD

Name Herbert McGrobieService No. 100Address 9 Francis RoadLocation Lot # 132 & 133

Repair—Renewal—New Service

Comm 8-1-60


Date	Material	Amount	Total	Date	Amount	
6-23-60	Labor	1 77		8-22-60	Deposit	35 00
	10% O.F.	18	1 95	8-1-60	Returned	7 36
46'	3/4" Copper tubing #42		19 32			27 44
1	3/4" 3x4 I. . . T. Stop Waste		6 17		NON CHARGE	
			27 44	10-22-59	Labor	3 70
					10' 3/4" Copper tubing @.41	4 10
					1 3/4" C Corp Cock	4 64
					1 3/4" C Curb Cock	5 94
					1 Box & Rod	5 00
					1 Hr. Trucking	75
						24 13
					1 1/2 Straight tailpiece	50
					1 1/2 Offset tailpiece	50
						25 13

DATE _____

TOWN OF LEXINGTON — BOARD OF PUBLIC WORKS

WATER DIVISION

Sketch of Service Here

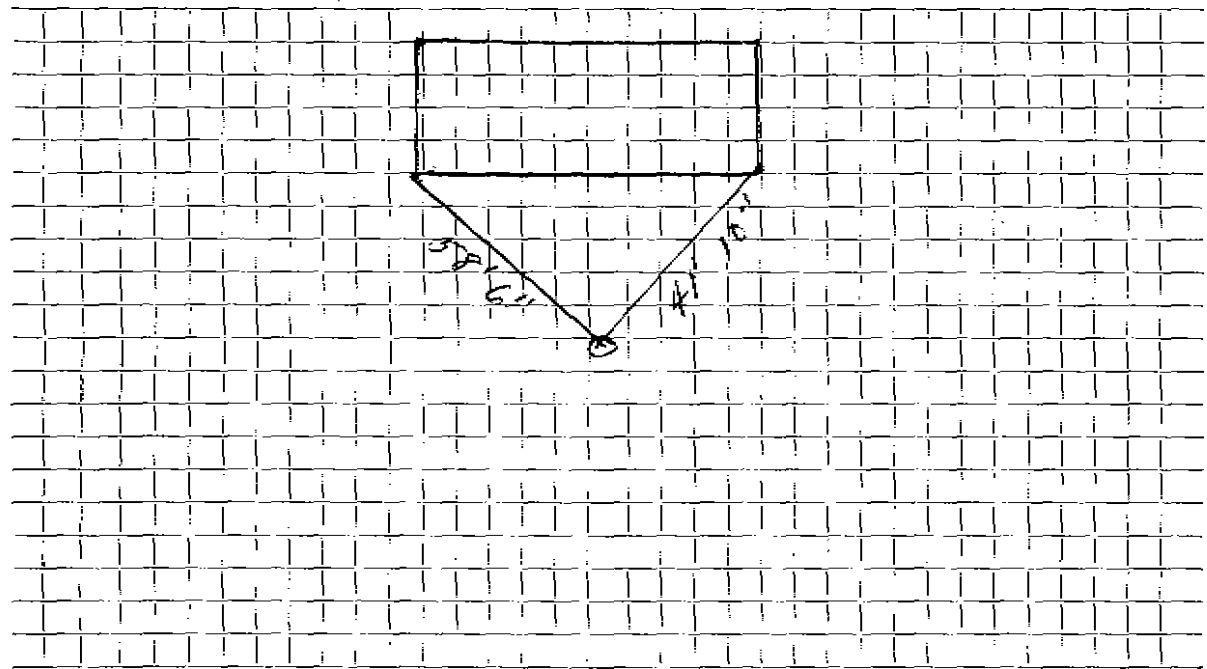

Connection made in Street. Work completed

Remarks:

.....
.....
.....