

Name **Kelsey Reed**

Service No. ³⁵

788

Address 10 Franklin Road

Location 10 Franklin Road

Kind of Pipe

Size

Size of Main

~~Repair~~—Renewal—~~New Service~~

Location

Date	Material	Amount	Total	Date	Location	Amount
May 26, '47	Labor	9 80		May 23 47	Deposited	100 00
27	"	29 33	39 13	Dec. 31	Refunded	30 68
	10% Overhead		3 91		Non-Charge	69 32
	78' - 3/4" Copper Tubing @.27		21 06	May 27, '47	Labor	22 05
	1 - 3/4" C x 1/2" I.W.H. S & W		3 15	18' - 3/4" Copper Tubing @.27		4 86
	1 - 3/4" C x 3/4" C Union 3 pts.		1 32	1 - 3/4" C x 3/4" C Curb-cock		3 68
	Trucking 1 hr. @.75		75	1 - 3/4" C Adapter		1 32
			69 32	1 - Box & Rod		4 26
				1 - 1/2" Offset Tail Piece		30
				1 - 1/2" Straight Tail Piece		30
				Patching 8 x 3		8 00
				Compressor 1 hr. @ 1.75		1 75
	Labor			Trucking 1 hr. @.75		75
						47 27

TOWN OF LEXINGTON - BOARD OF PUBLIC WORKS

WATER DIVISION

The undersigned applies for a supply of water at No..... St. and hereby agrees to comply with the rules and regulations as now, or at any future time, established by the Board of Selectmen.

Am't of Estimate \$.....


Owner

Am't Paid \$.....

Address

Builder

Sketch of Service Here

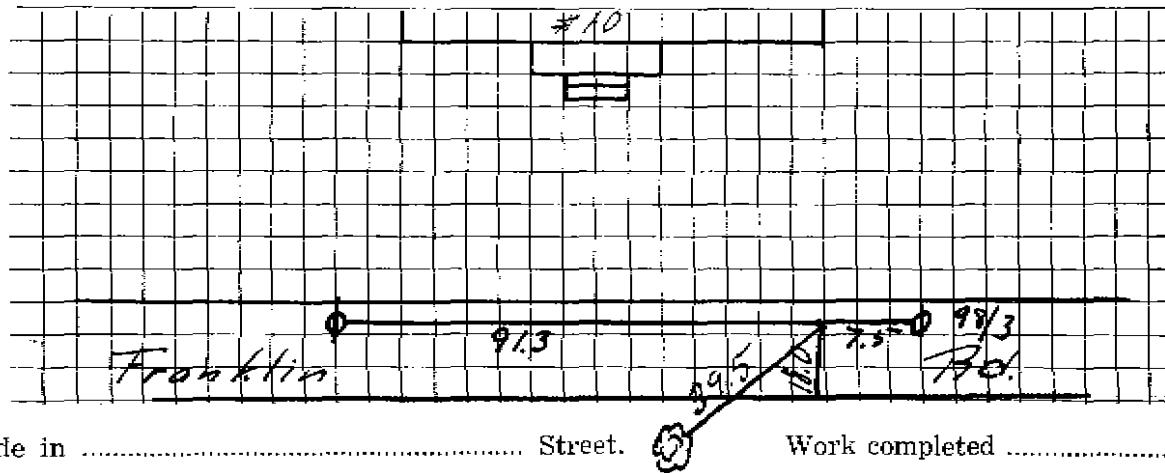

Connection made in Street.

Work completed19

Remarks:

WATER SERVICE RECORD

Name

Service No.

Address 10 FRANKLIN ROAD

Location CORPORATION ON 8" MAIN

Repair Renewal - New Service WATER MAIN CLEANING & LINING PROJECT C99-02: BISZKO Co.


Date	Material	Amount	Total	Date	Amount
				7-6-1999	
				20'	1" COPPER BTW CORPORATION & CURBSTOP/BOX
				1	CORPORATION
				1	CURBBOX/STOP

DATE 7-6-1999

TOWN OF LEXINGTON — BOARD OF PUBLIC WORKS

WATER DIVISION

Sketch of Service Here

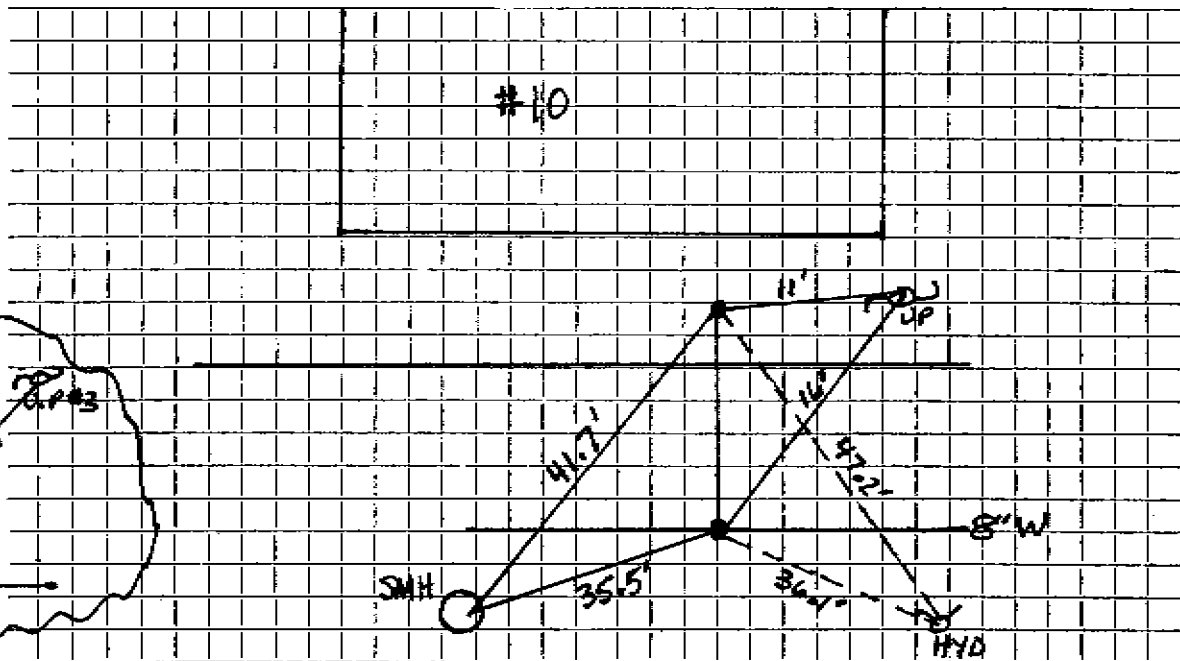

Connection made in 8" D.I. PIPE ON FRANKLIN RD Street.

Work completed NEW CORPORATION, CURBSTOP/BOX

Remarks:

.....

.....