

WATER SERVICE RECORD

Name E. Fay Bishop

Service No.

73

Address 15 Franklin Rd.

# 4633

Location Lexington

~~Repair/Reconnect~~ - New Service

CON. 6-8-53


Date	Material	Amount	Total	Date	Amount
5/8/53	Labor	1 90		4-16-53	Deposited 25 00
	10% overhead	19	2 09	6-8-53	Refunded (3 54)
	43' 3/4" Copper Tubing @.34		14 62		NON CHARGE 21 46
	1-3/4" C x 1/2 I.W.H. STOP & WASTE		4 00	5/8 53	Labor
	1 Hr. Trucking		75		27'-3/4" Copper Tubing @.34
			21 46		1-3/4" C. Corp-cock
					1-3/4" C x 3/4" C. Curb-cock
					1-Box & Rod
					1-1/2 straight tail piece
					1-1/2 offset tail piece
					1 Hr. Trucking
					75
					25 73

DATE \_\_\_\_\_

TOWN OF LEXINGTON — BOARD OF PUBLIC WORKS

**WATER DIVISION**

Sketch of Service Here

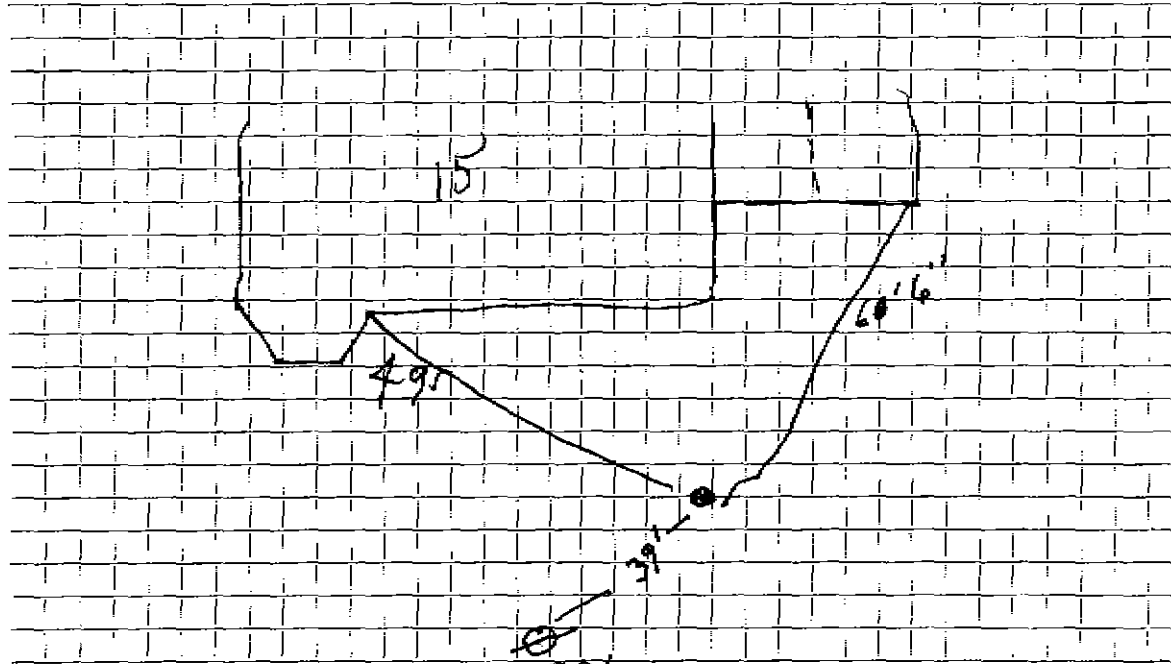

Connection made in ..... Street.  $98\frac{1}{2}$  Work completed .....

Remarks: .....  
.....  
.....




DATE 7-7-1999

TOWN OF LEXINGTON — BOARD OF PUBLIC WORKS

WATER DIVISION

Sketch of Service Here

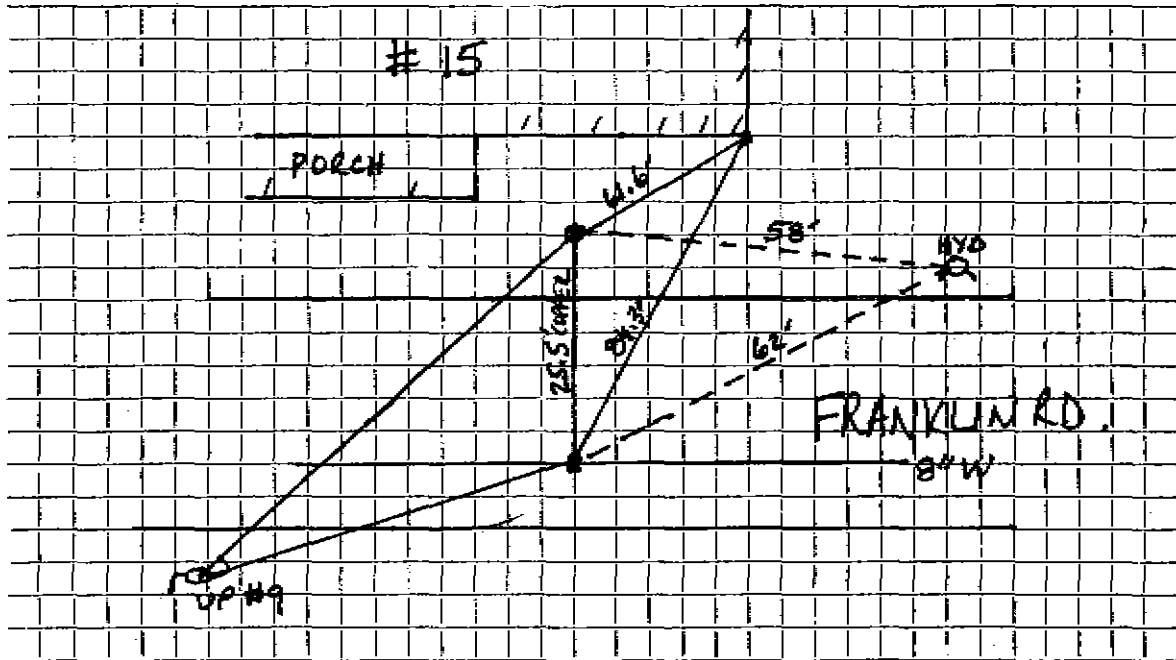

Connection made in 8" MAIN ON FRANKLIN RD. Street.

Work completed NEW CONNECTION, CURB STOP/BOX

Remarks: .....

.....

.....