

WATER SERVICE RECORD

Name William Bond

Service No. 11

Address 16 Franklin Road

Location

~~Repair~~ - Renewal - ~~New Service~~ W.O. #6302

JUL 24 1978


Date	Material	Amount	Total	Date	Amount
5/22/78	Labor	269.53			
	10% O.H.	26.95	296.48	5-18-78	Deposit 400.00
	76' 3/4" Copper tubing @.83		63.08		
	1 3/4" 3 part Union		6.02		OUTSIDE
	1 3/4" Stop & Waste		17.10	5/19-22/78; 7/10/78	labor
	1 3/4" x 1/2" Reducer		1.56		15 ft. 3/4 copper tubing
	1 5/8" Tailpiece		1.00		1 3/4" curb
	8 yds. Loam @ 5.44		43.52		1 3/4" corp.
	10 lbs. Grass Seed @.74		7.40		1 rod
	1 bag Fertilizer		4.00		5 yrds. gravel
	1 bag Lime		1.00		1 ton cold patch
	3 1/2 hrs. Trucking @3.00		10.50		2 yrds. loam
	3 hrs. Backhoe @6.50		19.50		1/2 bag turf food
	1 hr. Loader		4.00		1/2 bag lime
			475.16		5 lbs. seed
					Trench 13 by 6

DATE _____

TOWN OF LEXINGTON — BOARD OF PUBLIC WORKS

WATER DIVISION

Sketch of Service Here

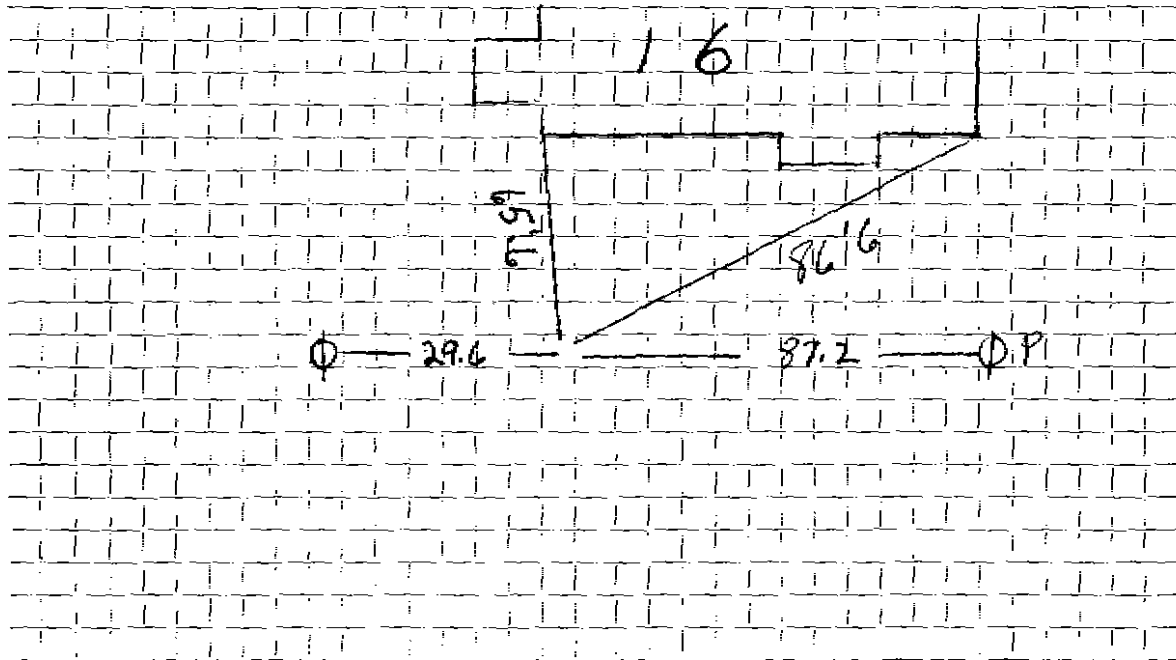


Connection made in Street. Work completed

Remarks:
.....
.....

DATE 7-8-1999

TOWN OF LEXINGTON — BOARD OF PUBLIC WORKS
WATER DIVISION

Sketch of Service Here

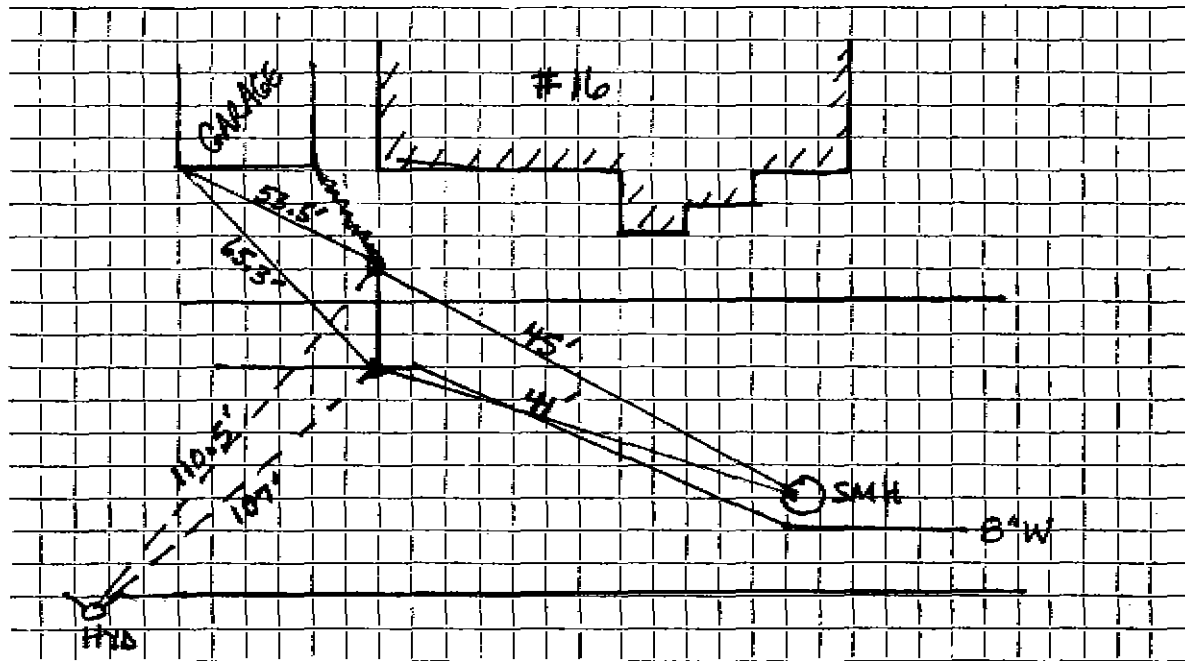

Connection made in 8" MAIN ON FRANKLIN RD Street. Work completed NEW CONNECTION, CURBSTOP/BOX.....

Remarks: 2' ADJACENT TO SERVICE, A 4" IRON DOWNSPOUT WATER DISCHARGE PIPE PRESENT.