

3981

WATER SERVICE RECORD

Name Paul V. Roberts

Service No. 3

Address 17 Franklin Road

6870

Location

~~Repair~~ ~~Renewal~~ New Service

Com. 5-3-54


Date	Material	Amount	Total	Date	Amount
1/16/51	Labor	1 85		3-29-54	25 00
	10% overhead	19	2 04	5-3-54	2 46
	45'-3/4" Copper tubing @.35	15 75			NON CHARGE
	1-3/4" 3x1/2 I.W.H. Stop & waste	1 00		1/16/51	Labor
	1 hr trucking		75	3' 3/4" Copper tubing @.35	1 05
			22 54	1-3/4" C.Corp cock	1 33
				1-3/4" 6x3/4 C.curb cock	1 67
				1- Box & Rod	3 90
				1-3/8 Straight tail piece	50
				1-1/2 Offset tail piece	50
				1 hr trucking	75
					17 55

DATE _____

TOWN OF LEXINGTON — BOARD OF PUBLIC WORKS

WATER DIVISION

Sketch of Service Here

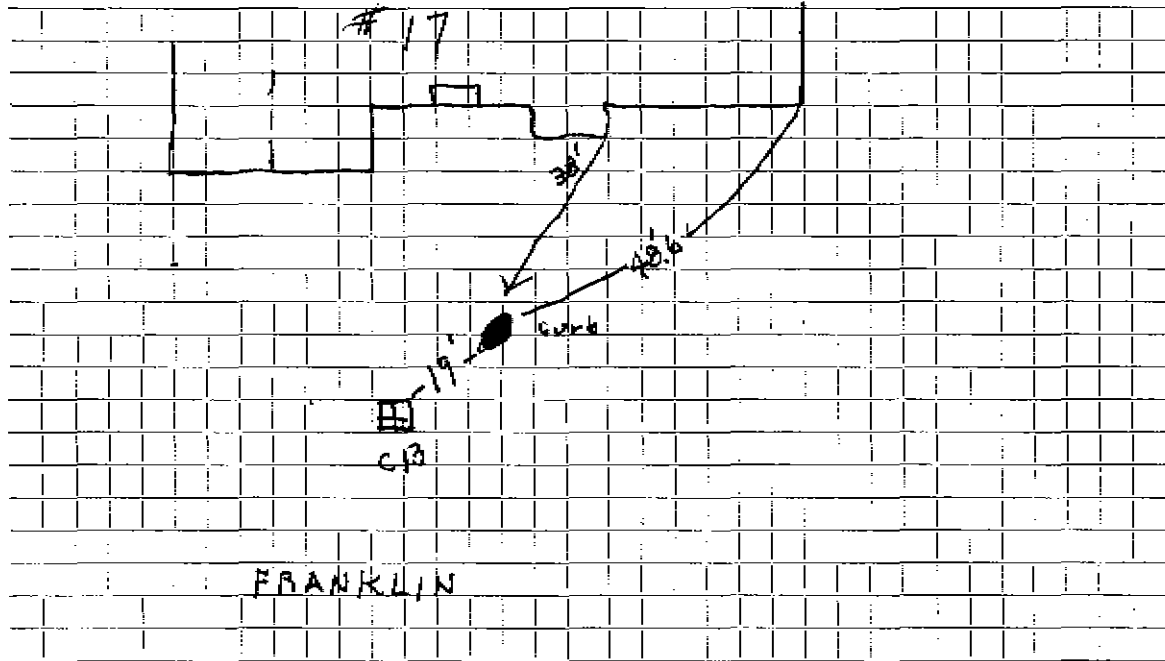

Connection made in Street. Work completed

Remarks:

.....

.....