


DATE 6-28-1999

TOWN OF LEXINGTON — BOARD OF PUBLIC WORKS

WATER DIVISION

Sketch of Service Here

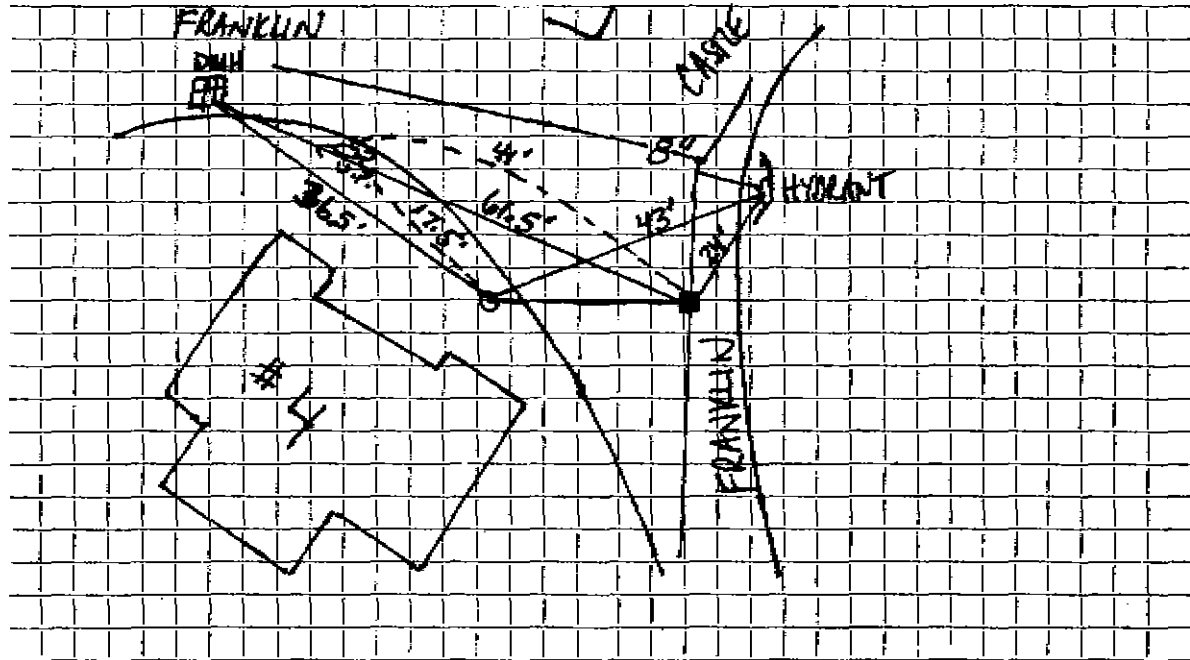

Connection made in 8" MAIN ON FRANKLIN Street.

Work completed NEW CORPORATION, CURB STOP/BOX

Remarks:

.....

.....

WATER SERVICE RECORD

1427

Name Charles H. Cole

Service No.

15

Address 4 Franklin Road

Location Lexington, Mass.

~~Repair - Renewal~~ - New Service

Com. 5-21-51

Date	Material	Amount	Total	Date	Material	Amount
2-27-51	Labor	1 50	1 50			
	10% Overhead		15			
	57' - 3/4" Copper Tubing @.36	20 52	20 52			
	1 - 3/4" C x 1/2" I.W.H. S&W	4 00	4 00	2-27-51	Labor	1 50
	Trucking 1 hr. @.75		75		37' - 3/4" Copper Tubing@.36	13 32
			26 92		1 - 3/4" C Corp-cock	4 33
					1 - 3/4" C x 3/4" C Curb-cocks	4 67
					1 - Box & Rod	4 68
					1 - 1/2" Offset Tail Piece	50
					1 - 1/2" Straight Tail Piece	50
					Trucking 1 hr. @.75	75
						30 25

June 21st

*Estimated
Paid*

25 00

1 92

No Charge

26 92


26 92

DATE _____

TOWN OF LEXINGTON — BOARD OF PUBLIC WORKS

WATER DIVISION

Sketch of Service Here

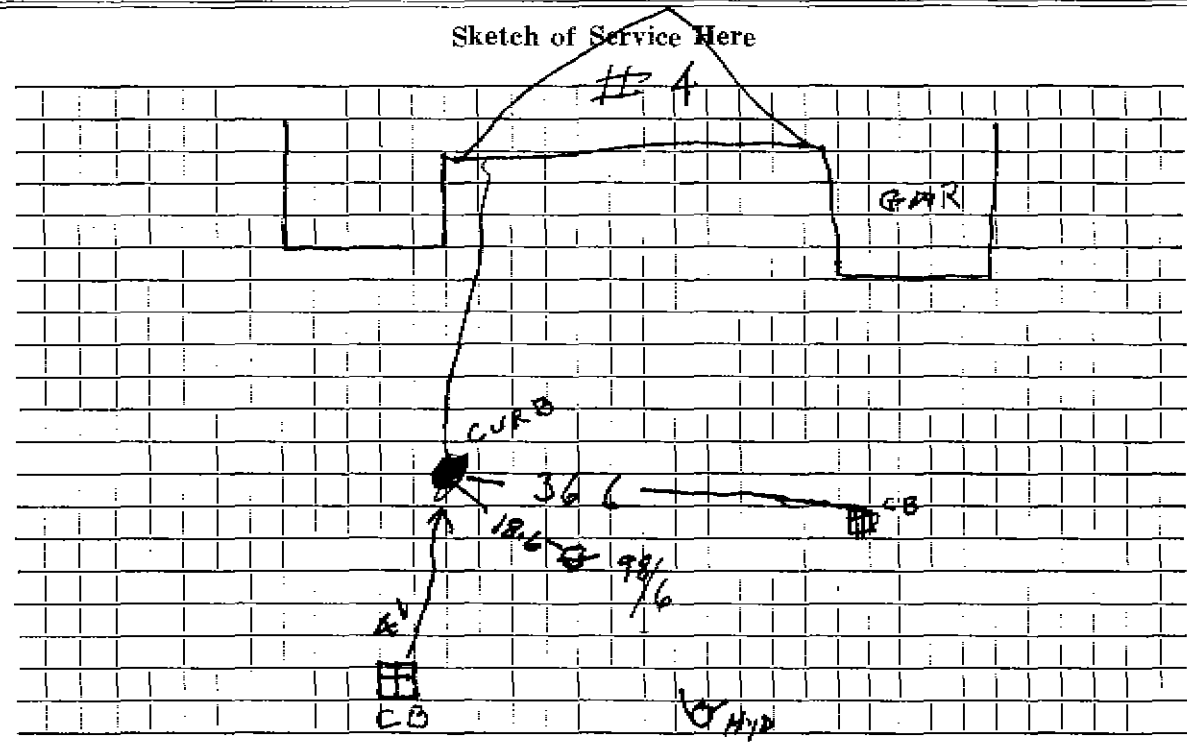

Connection made in Street. Work completed

Remarks:
.....
.....