

WATER SERVICE RECORD

11408

Name ~~Meado, Inc.~~ ELAINE TANG

Service No. 14

Address 5 Franklin Road

Location Lexington, Mass.

~~Repair~~ ~~Renewal~~ ~~New Service~~ COM. 2-25-52 RENEWAL PERMIT NO. 0975- J.M. MCLAUGHLIN


| Date | Material | Amount | Total | Date | Amount |
|-----------------|---------------------------------------|--------|-------|--------------------------------|--------|
| 2/13/52 | Labor | 1 49 | 1 49 | 2-7-52 Deposited | 25 00 |
| | 10% overhead | | 15 | 3-10-52 Paid | 16 12 |
| | 96' -3/4" copper tubing@.3439 | | 33 01 | | 41 12 |
| | 1 - 3/4" C x 1/2" I.W.H. stop & waste | | 4 00 | 2/13/52 Labor | 1 49 |
| | 1 - 3/4" C x 3/4" C. union 3pts. | | 1 72 | 45' - 3/4" copper tubing@.3439 | 15 47 |
| | 1 - hr. trucking | | 75 | 1 - 3/4" C. corp-cock | 4 33 |
| | | | 41 12 | 1 - 3/4" C x 3/4" C. curb-cock | 4 67 |
| | | | | 1 box and rod | 4 52 |
| | | | | 1 - 1/2" straight tail piece | 50 |
| | | | | 1 - 1/2" offset tail piece | 50 |
| | | | | 1 hr. trucking | 75 |
| | | | | | 32 23 |
| AUGUST 14, 1997 | 115' - 1" φ COPPER | | | | |

DATE AUGUST 14, 1997

TOWN OF LEXINGTON — BOARD OF PUBLIC WORKS

WATER DIVISION

Sketch of Service Here

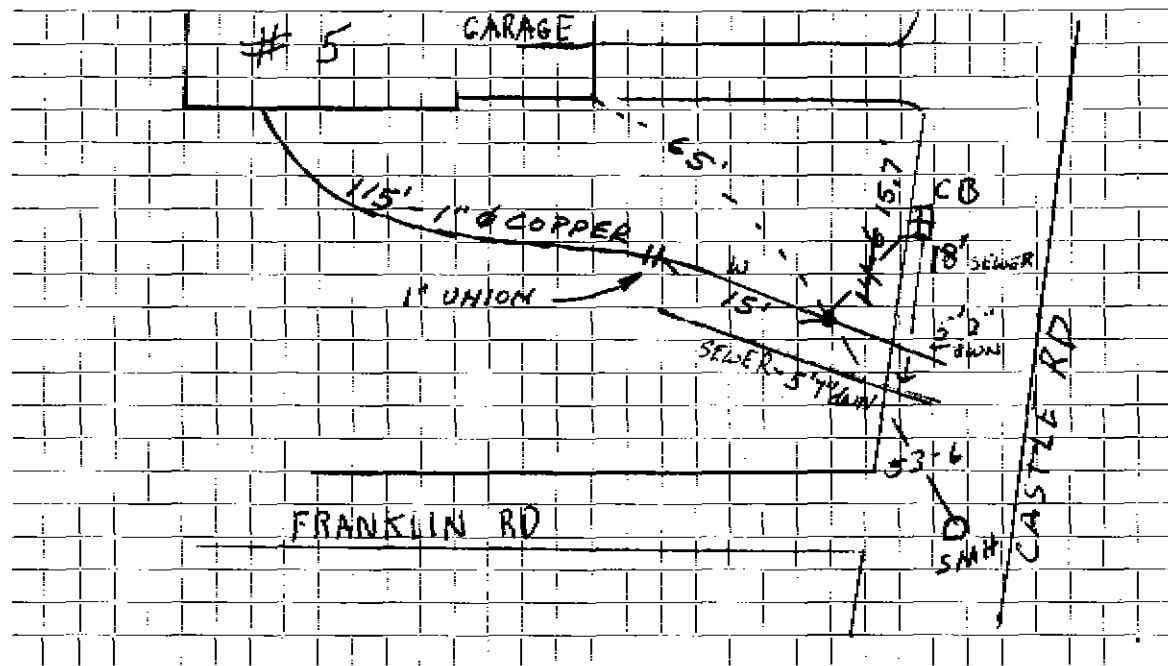

Connection made in Street. Work completed

Remarks:

PPH 973

W.